


GRANT COUNTY

Section Summary

29
1 N
1 W
SECTION TOWN RANGE

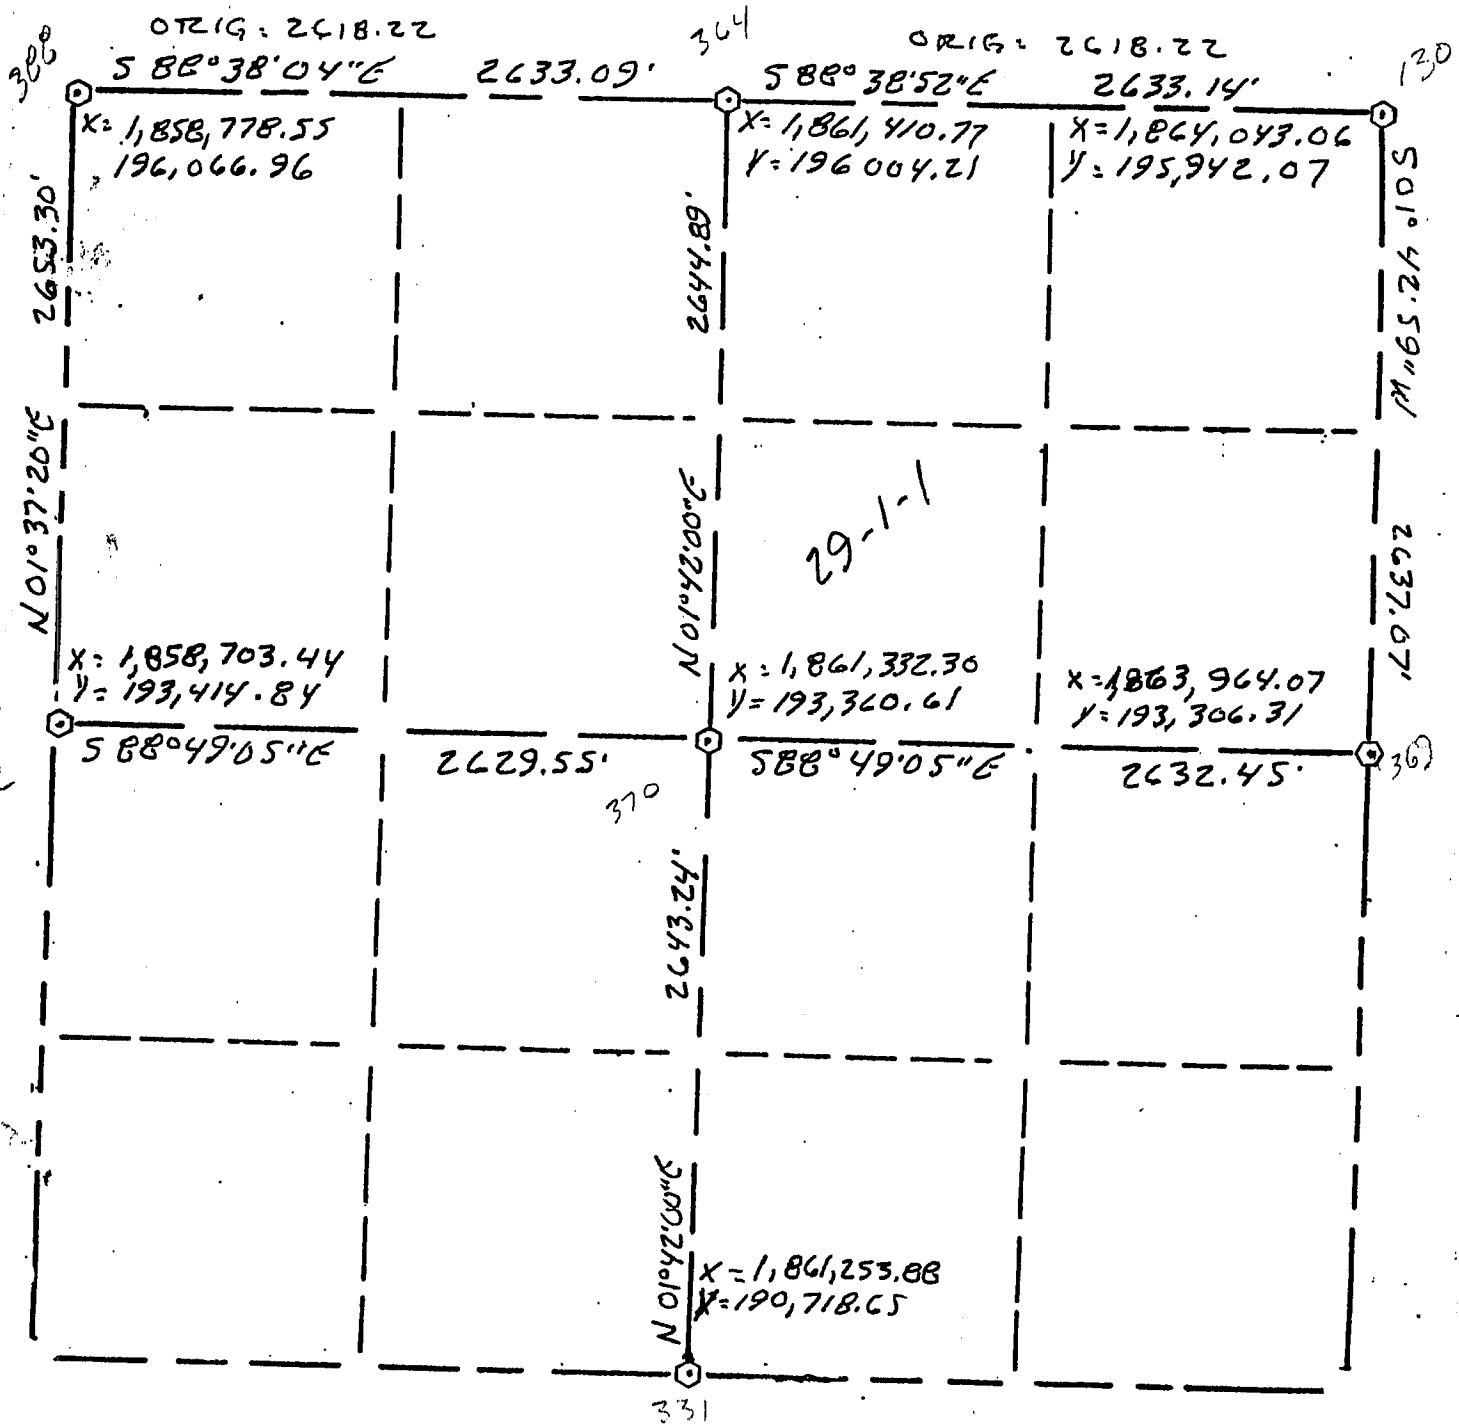

Grid coordinates computed from information supplied by DOT survey along Hwy. 11 in 1990; the ground distances shown would be multiplied by a combination factor of .999955;


LEGEND

- ▲ COUNTY MONUMENT
- STONE OR CONCRETE MONUMENT
- ⊙ OTHER (specify) 2" X 30"
Aluminum Monument W/ DOT Cap Set

NOTE:

Relationships of all section corners to other section corners shall be shown hereon by bearing and distance or grid coordinates

Show or describe bearing reference (see above)

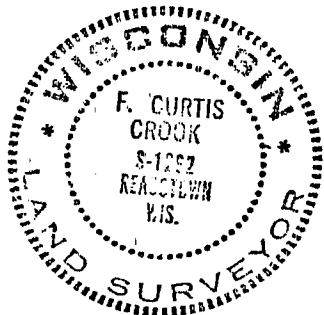

Surveyed Jan. - Feb. 1991

F. Curtis Crook 3-11-96

F. Curtis Crook

RLS #1292