

Prepare's Name: Kenneth L. Buesing Address: 1212 Locust St. Dubuque, IA Telephone: (563) 556-4389

SLSI 9-94

UNITED STATES PUBLIC LAND SURVEY MONUMENT RECORD

OF

Land Survey Monuments situated in Section 4, Township 1N, Range 2W, of the Fifth Principal Meridian, GRANT County, Wisconsin, Previously recorded in SEE BELOW in County Recorder's Office.
(book, page, document number, etc.)

(Show reason for preparing this certificate, the evidence and detailed procedures used in establishing the corner positions and monumentation found or placed.)

Monument Description and Remarks: FOUND 2" IRON PIPE @ THE N1/4 CORNER. EXPOSED 2".


PREVIOUS MONUMENT RECORD DATED: APRIL 22, 1983 BY: GARY A. WATTS (RETIED DUE TO LOST TIES)

PLACED 24" x 3/4" IRON REROD BAR @ THE NE CORNER OF THE NW1/4 NE1/4. EXPOSED 2"

ESTABLISHED BY GOING EAST 1305.51' FROM THE N1/4 CORNER TOWARDS THE NE CORNER, PER CSM 347 PAGE 194.

PLAN - VIEW


(Show a minimum of three reference ties to durable physical objects, relevant monuments and physical conditions that will enable recovery of the corner.)

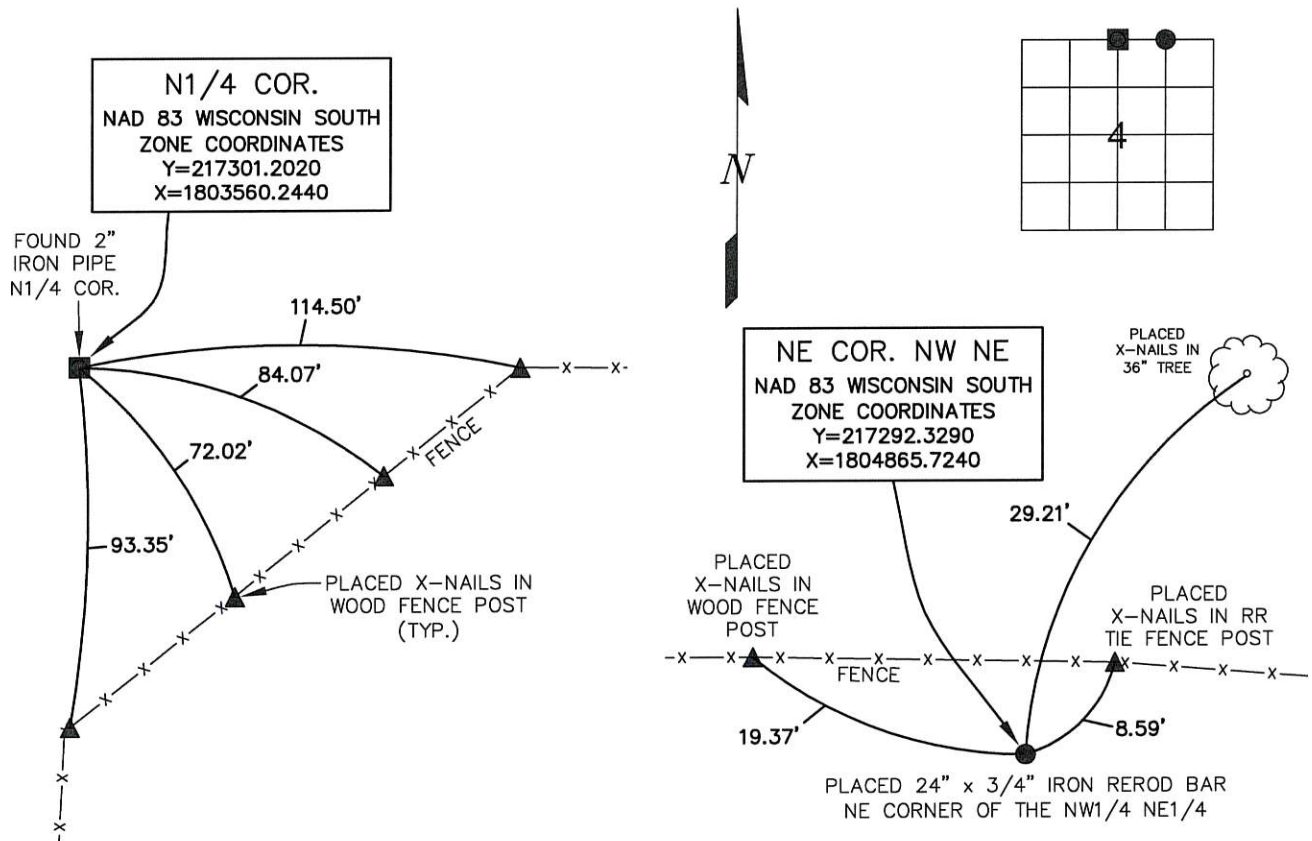

I HEREBY CERTIFY THAT THIS LAND SURVEYING DOCUMENT WAS PREPARED AND THE RELATED SURVEY WORK WAS PERFORMED BY ME OR UNDER MY DIRECT PERSONAL SUPERVISION AND THAT I AM A DULY LICENSED LAND SURVEYOR UNDER THE LAWS OF THE STATE OF WISCONSIN.

Kenneth L. Buesing 25 Jan. 2017
 KENNETH L. BUESING (DATE)

LICENSE NUMBER S-2217
 MY LICENSE RENEWAL DATE IS JANUARY 31, 2018

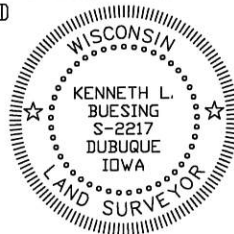

List Corners to be Indexed	Section	Twp	Range
N1/4 COR.	4	1N	2W
NE COR. NW1/4 NE1/4	4	1N	2W

 1212 LOCUST ST, DUBUQUE, IA (563) 556-4389	MONUMENT RECORD		
	COUNTY: <u>GRANT</u>	TOWNSHIP: <u>JAMESTOWN</u>	
DATE PLOTTED: 11-18-16	FIELD BOOK # .	DRAWING # 16270-01	
DATE REVISED:	PAGE # SHOT IN		