

U.S. PUBLIC LAND SURVEY MONUMENT RECORD - GRANT COUNTY, WI

Section 8, Town 1 North Range 2 West, Town of Jamestown (a)


NOTE: This form is intended and designed to fulfill all requirements of the Wisconsin Administrative Code Chapter A-E 7.08, U.S. Public Land Survey Monument Record (3) (a) (b) (c) (d) (e) (f) (g) (h) (i).

CERTIFICATE: (i)

I, Aaron J. Austin, Wisconsin Professional Land Surveyor, do hereby certify that the corner location on this record was determined by me and/or under my direct supervision and that this U.S. Public Land Survey Monument Record is correct and complete to the best of my knowledge and belief.

Dated this 12th day of December, 2018.

Aaron J. Austin
Aaron J. Austin, S-2922

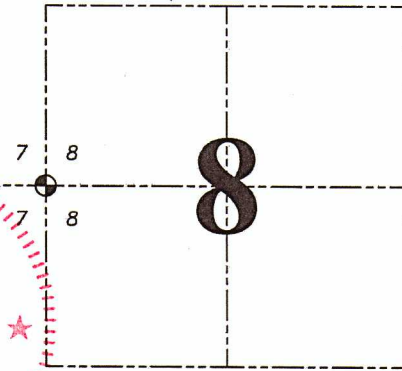

⊕ = CORNER LOCATION

HISTORY OF CORNER ESTABLISHMENT:

Lucius Lyon set the original corner in 1832. In 1853 Overton tied to the corner on a survey filed in Book B Page 331. Larry Austin found a 2" Iron Pipe on a survey filed in Book W Page 70. Several other surveys have accepted the 2" Iron Pipe as the corner.

DESCRIPTION OF CORNER EVIDENCE FOUND: (b) (f) (g) (h)

I found the 2" Iron Pipe that was tied to by previous surveyors. I set four witness monuments after I verified the corner's location with G.P.S. and E.D.M. methods.

DESCRIPTION OF CORNER AND WITNESS MONUMENTS, references and accessories used to perpetuate the original or re-established location of this corner. (c) (d) (e)

Witnesses to corner location Shane Austin, Owen Austin. Drawn by Owen Austin.

SKETCH:

LEGEND

- ⊕ Section Corner—as designated
- 3/4" x 18" rebar set
- ☉ Existing tree
- ××× Existing fence

