

12038-5
and
12038

Prepare's Name: Kenneth L. Buesing Address: 1212 Locust St. Dubuque, IA Telephone: (563) 556-4389

SLSI 9-94

UNITED STATES PUBLIC LAND SURVEY MONUMENT RECORD

OF

Land Survey Monuments situated in Section 11, Township 1N, Range 2W, of the Fourth Principal Meridian, GRANT County, Wisconsin, Previously recorded in NONE in County Recorder's Office.
(book, page, document number, etc.)

(Show reason for preparing this certificate, the evidence and detailed procedures used in establishing the corner positions and monumentation found or placed.)

Monument Description and Remarks: FOUND MAG NAIL IN ASPHALT @ THE W1/4 CORNER.


REPLACED WITH 24" x 3/4" IRON REROD BAR & GRANT COUNTY ALUMINUM CAP. BURIED 1" IN ASPHALT.

PLACED 24" x 3/4" IRON REROD BAR & GRANT COUNTY ALUMINUM CAP @ THE CENTER. BURIED 1" IN ASPHALT

ESTABLISHED BY INTERSECTING THE NORTH-SOUTH & WEST-EAST 1/4 SECTION LINES.

PLAN - VIEW


(Show a minimum of three reference ties to durable physical objects, relevant monuments and physical conditions that will enable recovery of the corner.)

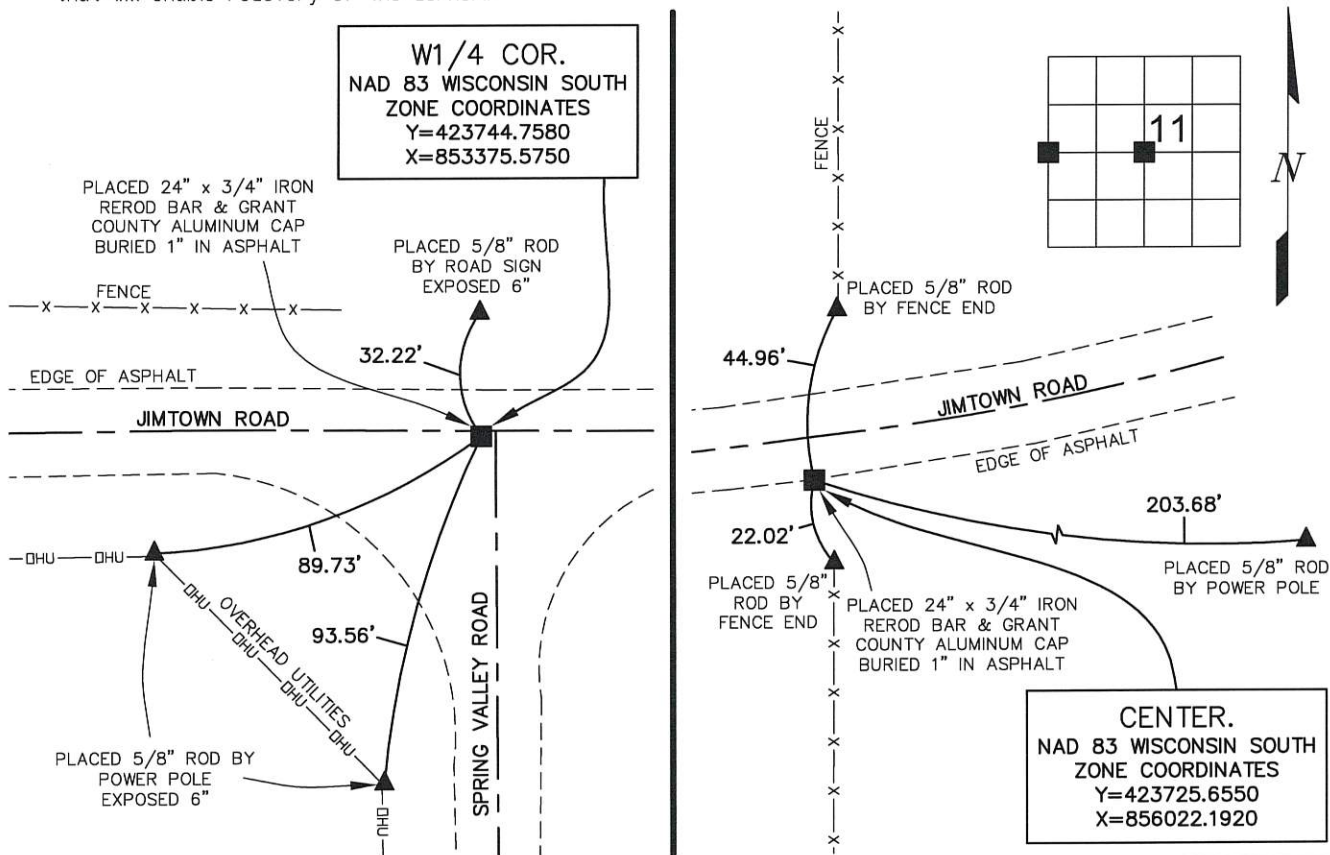

I HEREBY CERTIFY THAT THIS LAND SURVEYING DOCUMENT WAS PREPARED AND THE RELATED SURVEY WORK WAS PERFORMED BY ME OR UNDER MY DIRECT PERSONAL SUPERVISION AND THAT I AM A DULY LICENSED LAND SURVEYOR UNDER THE LAWS OF THE STATE OF WISCONSIN.

Kenneth L. Buesing 5, Apr. 1 2018
KENNETH L. BUESING (DATE)

LICENSE NUMBER S-2217
MY LICENSE RENEWAL DATE IS JANUARY 31, 2020

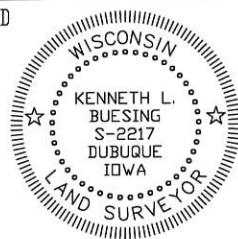

Corners	Section	Twp	Range
W1/4 COR.	11	1N	2W
CENTER	11	1N	2W

 1212 LOCUST ST, DUBUQUE, IA (563) 556-4389	MONUMENT RECORD		
	COUNTY: <u>GRANT</u>	TOWNSHIP: <u>JAMESTOWN</u>	
DATE PLOTTED: 3-14-18	FIELD BOOK # .	DRAWING # 18025-01	
DATE REVISED:	PAGE # SHOT IN		