

# GRANT COUNTY CERTIFIED LAND CORNER


CORNER NUMBER 61

**CERTIFICATE:**

I, Larry L. Austin, do hereby certify that on the 11th day of May, 2000, I found evidence of the Northeast corner of Section 24, Town 1 North, Range 2 West, of the 4th Principal Meridian, and I re-established said corner according to the Wisconsin statutes as shown and described hereon.

Dated this 8th day of September, 2000

*Larry L. Austin*  
Larry L. Austin S-1903

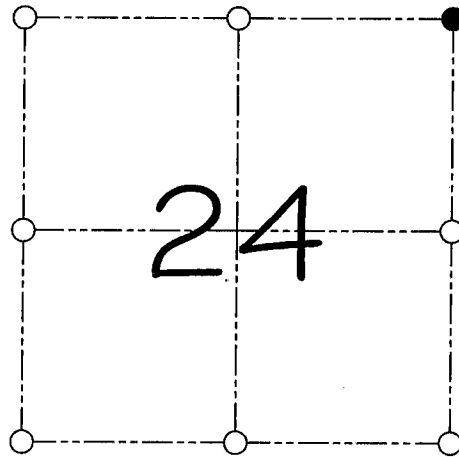

● = CORNER LOCATION

NORTHEAST CORNER OF  
SECTION 24, T 1 N R 2 W  
TOWN OF JAMESTOWN

**HISTORY OF ORIGINAL CORNER ESTABLISHMENT:**

Corner was originally set in 1832 by Lucius Lyon.  
In 1879 Joel Barber found an ancient rock.

**DESCRIPTION OF CORNER EVIDENCE FOUND:**

I did not find the ancient rock. I did find a 2" iron pipe at this location after measuring to adjacent occupied and monumented corners.

**DESCRIPTION OF CORNER AND WITNESS MONUMENTS, references and accessories used to perpetuate the original or re-established location of this corner**

WITNESS TO THE CORNER LOCATION: SHELBY BLINDERT & BOBBY SEDGWICK

**SKETCH:**

