

MAY 04 2018

12119.5, 12119.75, 12220

Prepare's Name: Kenneth L. Buesing Address: 1212 Locust St. Dubuque, IA Telephone: (563) 556-4389

SLSI 9-94

UNITED STATES PUBLIC LAND SURVEY MONUMENT RECORD

OF


Land Survey Monuments situated in Section 36, Township 1N, Range 2W, of the Fourth Principal Meridian, GRANT County, Wisconsin, Previously recorded in NONE in County Recorder's Office.

(Show reason for preparing this certificate, the evidence and detailed procedures used in establishing the corner positions and monumentation found or placed.)

Monument Description and Remarks: PLACED MAGNAIL @ E 1/4 COR. ESTABLISHED USING THE SECTION TIES FROM CORNER CERTIFICATE #113-114. PLACED 3/4" IRON REROD @ CENTER OF SECTION. ESTABLISHED BY USING THE INTERSECTION OF THE NORTH-SOUTH & EAST-WEST 1/4 SECTION LINES. BURIED 3". PLACED 3/4" IRON REROD @ NE COR NW1/4, SE1/4. ESTABLISHED BY USING THE MIDPOINT BETWEEN THE E 1/4 COR AND THE CENTER. BURIED 3"

PLAN - VIEW

(Show a minimum of three reference ties to durable physical objects, relevant monuments and physical conditions that will enable recovery of the corner.)

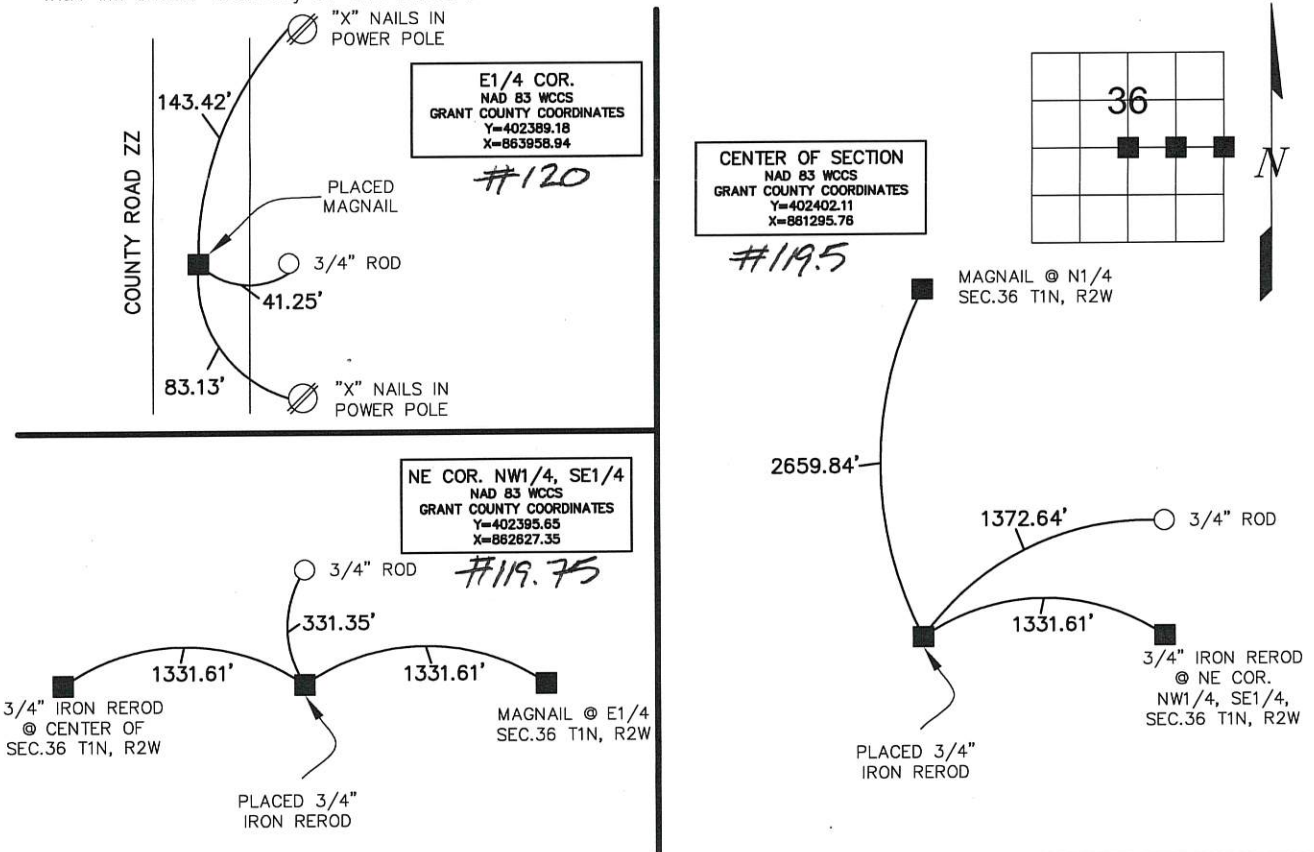

I HEREBY CERTIFY THAT THIS LAND SURVEYING DOCUMENT WAS PREPARED AND THE RELATED SURVEY WORK WAS PERFORMED BY ME OR UNDER MY DIRECT PERSONAL SUPERVISION AND THAT I AM A DULY LICENSED LAND SURVEYOR UNDER THE LAWS OF THE STATE OF WISCONSIN.

Signature of Kenneth L. Buesing, dated 27 Apr. 2018

Kenneth L. Buesing, License Number S-2217, My License Renewal Date is January 31, 2020

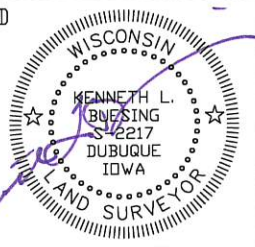


Table with 4 columns: Corners, Section, Twp, Range. Lists E 1/4 COR., CENTER, and NE COR. NW1/4, SE1/4.

BUESING & ASSOCIATES INC. ENGINEERS AND SURVEYORS. 1212 LOCUST ST, DUBUQUE, IA (563) 556-4389

MONUMENT RECORD. COUNTY: GRANT, TOWNSHIP: JAMESTOWN. DATE PLOTTED: 3-14-18, DATE REVISED: FIELD BOOK # 171, PAGE # 1. DRAWING #16283-02 SEC.TIES