


Survey Monument Record

TYPE OF MONUMENT 3/4" X 24" IRON  
BAR SET

CORNER NO. 6  
SECTION 03  
TOWN 2N  
RANGE 1W

FIELD BOOK: 96-04  
PAGE \_\_\_\_\_

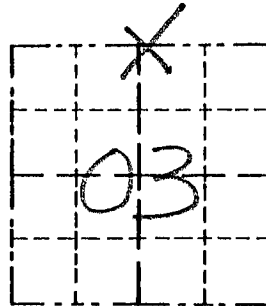

LOCATION  
(Indicated by "X")


BASIS FOR MONUMENT LOCATION

(Use reverse side if necessary)

Show info such as: History of corner, with reference to Vol. and pg., dates, surveyor; exact description of monument replaced; if location computed, by taped or EDM traverse; landowner, remarks, etc.

SEAL:

NO RECORD FOUND SINCE ORIGINAL SURVEY IN 1832 BY LYON. I ACCEPTED OCCUPATION LOCATION AND VERIFIED IT USING EDM METHODS

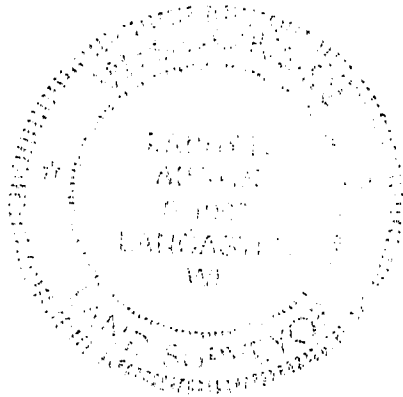

CERTIFIED CORRECT

Kerry J. Aust  
Registered Land Surveyor

DATE: 1-12-98

TIE SKETCH

Show at least three (3) ties and monument

LEGEND

- ⊕ 3/4" X 24" IRON BAR SET
- 1/2" X 15" IRON BAR SET
- XX EXISTING FENCE

