


GRANT COUNTY

Survey Monument Record

TYPE OF MONUMENT 1 1/2" OD. IRON PIPE
 STATE PLANE COORDINATES: N _____
 E _____
 ELEVATION — M.S.L. DATUM: _____
 THETA ANGLE: _____
 FIELD BOOK: 9105A
 PAGE 30

CORNER NO. 10
 SECTION 5
 TOWN 2N
 RANGE 1W
 N 1/4 CORNER

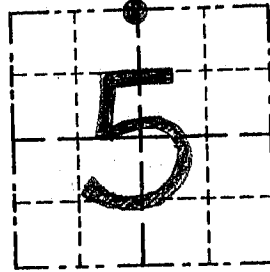

LOCATION
 (Indicated by "•")


BASIS FOR MONUMENT LOCATION

(Use reverse side if necessary)

Show info such as: History of corner, with reference to Vol. and pg., dates, surveyor; exact description of monument replaced; if location computed, by taped or EDM traverse; landowner, remarks, etc.

SEAL:

NO RECORD FD. OF CORNER
SINCE ORIGINAL SURVEY;
ACCEPTED OCCUPIED LOCATION
OF CORNER & VERIFIED BY
EDM TRAVERSE

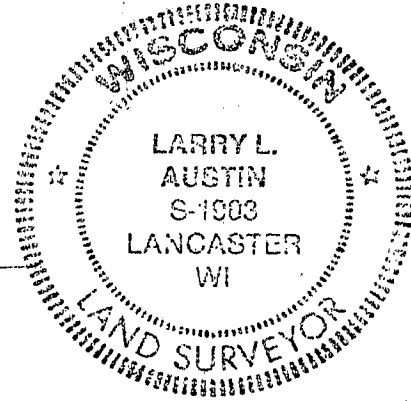


CERTIFIED CORRECT

Larry L. Austin
 Registered Land Surveyor

DATE: 6/12/94

TIE SKETCH

Show at least three (3) ties and monument

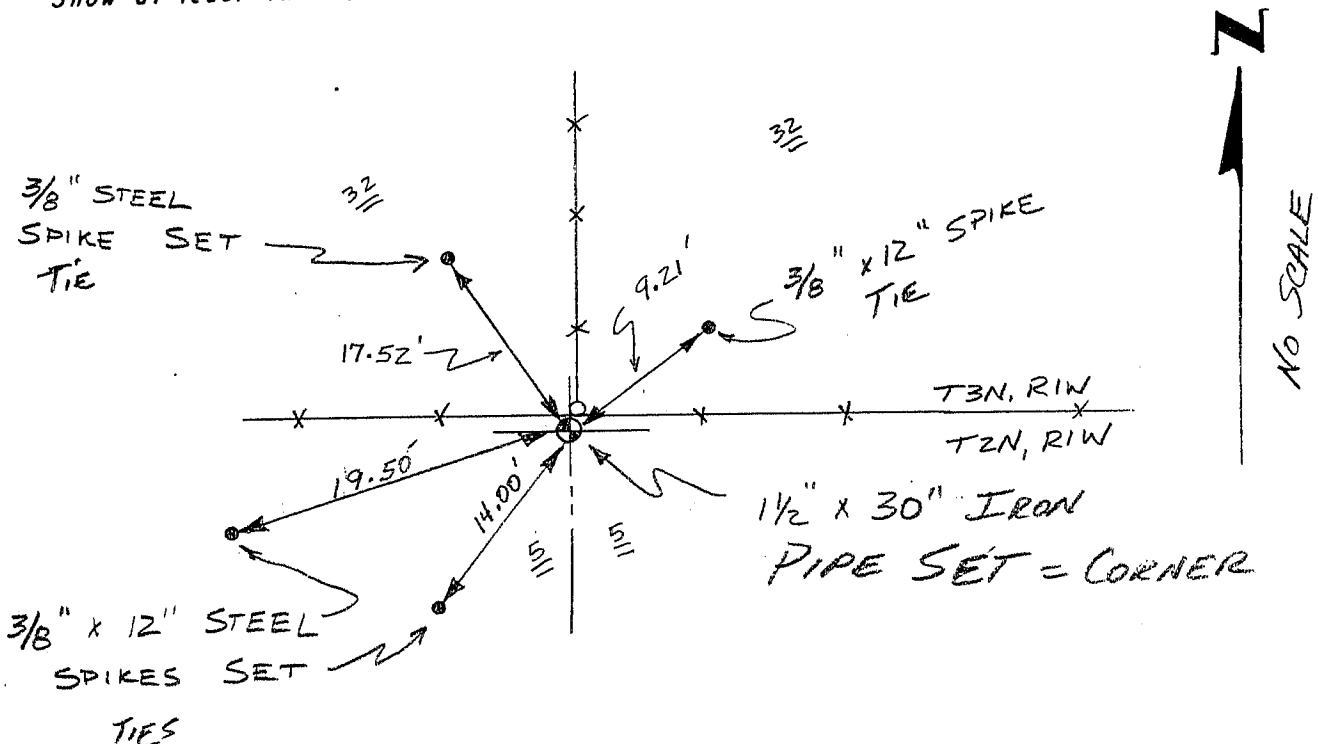

NO SCALE