


Survey Monument Record

TYPE OF MONUMENT 3/4" X 24" IRON
BAR SET

CORNER NO. 34
SECTION 07
TOWN 2N
RANGE LW

FIELD BOOK: 97-26
PAGE 7

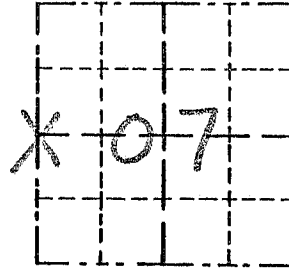


BASIS FOR MONUMENT LOCATION

(Use reverse side if necessary)

Show info such as: History of corner, with reference to Vol. and pg., dates, surveyor; exact description of monument replaced; if location computed, by taped or EDM traverse; landowner, remarks, etc.

SEAL:

CORNER SET IN 1832 BY LULIUS LYON. IN 1856 OVERTON SURVEYED A 29.93 ACRE PARCEL, NO MONUMENT PLACED. CORNER WAS SET MIDWAY ONLINE BETWEEN NORTHWEST AND SOUTHWEST CORNER OF SECTION, VERIFIED ITS LOCATION USING EDM METHODS.

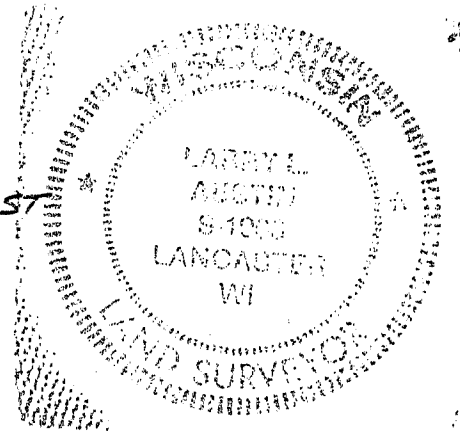

CERTIFIED CORRECT

Larry L. Austin
Registered Land Surveyor

DATE: 1-16-98

TIE SKETCH

Show at least three (3) ties and monument

LEGEND

- ⊕ 3/4" X 24" IRON BAR SET
- 1/2" X 15" IRON BAR SET
- XX EXISTING FENCE
- △ 2" IRON PIPE

