


GRANT COUNTY

Survey Monument Record

TYPE OF MONUMENT COUNTY MONUMENT
 STATE PLANE COORDINATES: N _____
 E _____
 ELEVATION — M.S.L. DATUM: _____
 THETA ANGLE: _____
 FIELD BOOK: 94-18
 PAGE: 28

CORNER NO. 50
 SECTION 17
 TOWN 2 N
 RANGE 1 W

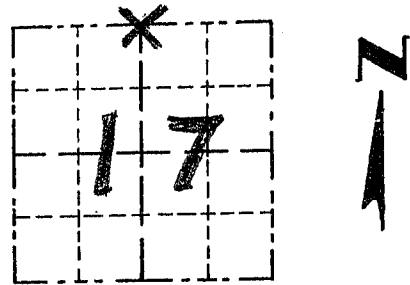


LOCATION
 (Indicated by "X")

BASIS FOR MONUMENT LOCATION

(Use reverse side if necessary)

Show info such as: History of corner, with reference to Vol. and pg., dates, surveyor; exact description of monument replaced; if location computed, by taped or EDM traverse; landowner, remarks, etc.

SEAL:

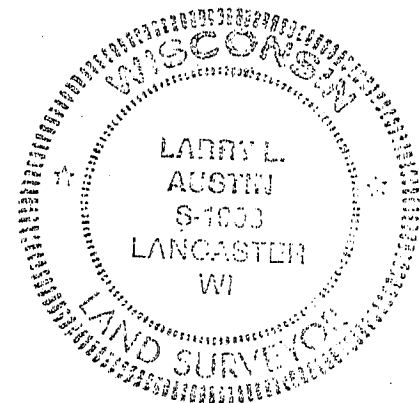

CORNER ORIG. SET IN 1832 BY LUCIUS LYON; NO RECORD OF CORNER FD. SINCE ORIGINAL SURVEYS; I SET THE CORNER MIDWAY BETWEEN NE & NW CORNERS OF THE SECTION & VERIFIED BY EDM TRAVERSE.

CERTIFIED CORRECT

Larry L. Austin
 Registered Land Surveyor

DATE: 3-9-95

TIE SKETCH

Show at least three (3) ties and monument

- LEGEND**
- GRANT COUNTY ALUMINUM MONUMENT SET
 - 1" IRON PIPE SET
 - TREE (AS NOTED)

