

GRANT COUNTY CERTIFIED LAND CORNER


CORNER NUMBER 53

CERTIFICATE:

I, LARRY L. AUSTIN, DO HEREBY CERTIFY THAT ON EIGHTH DAY OF MAY, 1999, I FOUND MONUMENTED EVIDENCE OF THE SOUTHWEST CORNER SECTION 7, TOWN 2 NORTH, RANGE 1 WEST, OF THE FOURTH PRINCIPAL MERIDIAN, AND I RE-ESTABLISHED SAID CORNER ACCORDING TO THE WISCONSIN STATUTES AS SHOWN AND DESCRIBED HEREON.

DATED THIS TWENTY-SECOND DAY OF MAY, 1999

Larry L. Austin
LARRY L. AUSTIN S-1903

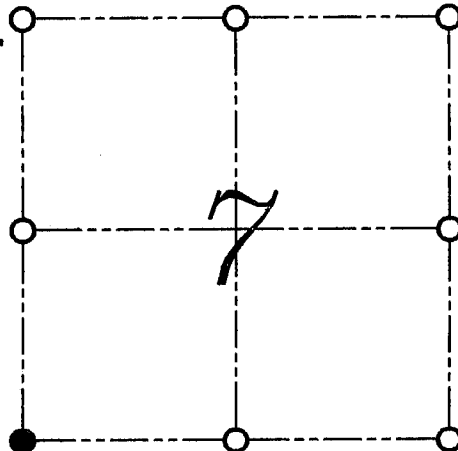

● = CORNER LOCATION
SOUTHWEST CORNER OF
SECTION 7, T 2 N R 1 W
TOWN OF SMELSER

HISTORY OF ORIGINAL CORNER ESTABLISHMENT:


CORNER WAS SET IN 1832 BY LUCIUS LYON.
I SET THE CORNER IN 1998.

DESCRIPTION OF CORNER EVIDENCE FOUND:

I FOUND THE 3/4" IRON BAR I SET IN 1998.
VERIFIED THIS LOCATION USING E.D.M. AND G.P.S. METHODS.

DESCRIPTION OF CORNER AND WITNESS MONUMENTS, REFERENCES AND ACCESSORIES USED TO PERPETUATE THE ORIGINAL OR RE-ESTABLISHED LOCATION OF THIS CORNER:
WITNESS TO THE CORNER LOCATION: BOBBY SEDGWICK ; SHELBY BLINDERT

SKETCH:

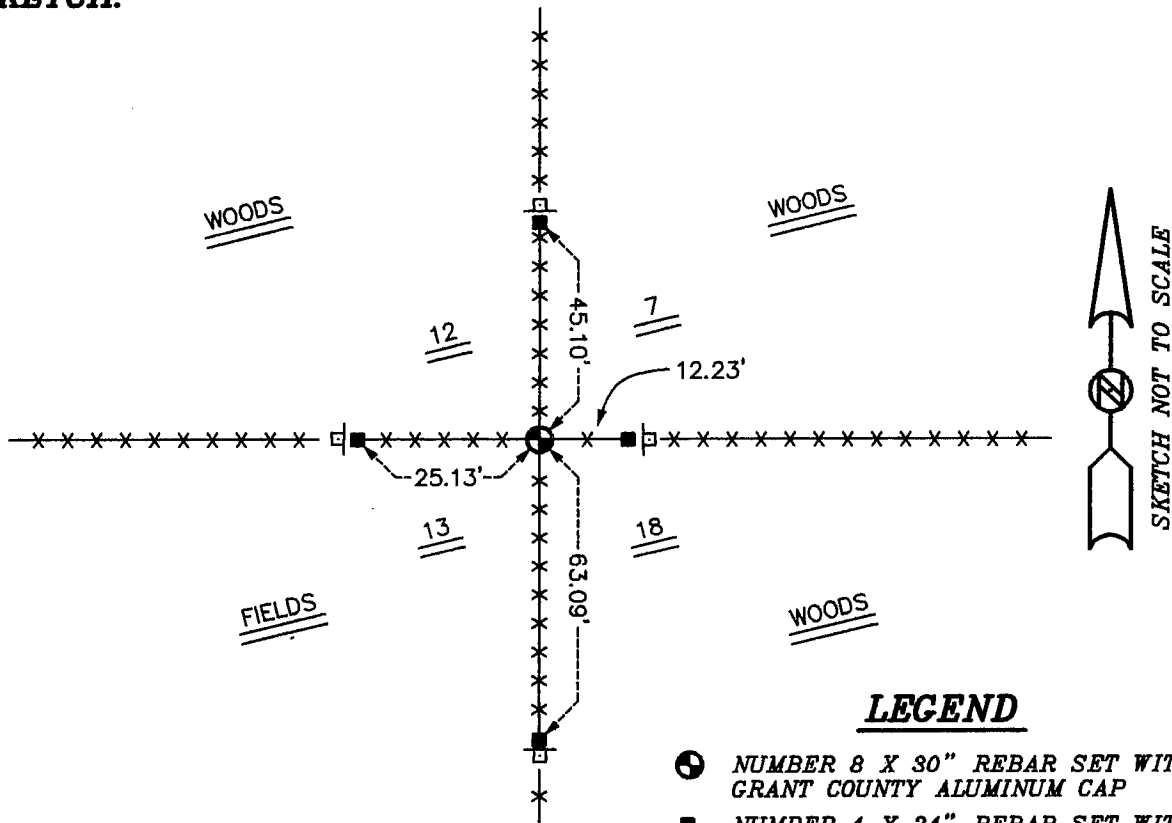

LEGEND


- ⊕ NUMBER 8 X 30" REBAR SET WITH GRANT COUNTY ALUMINUM CAP
- NUMBER 4 X 24" REBAR SET WITH RED PLASTIC CAP AND SIGN
- ×× EXISTING FENCE LOCATION
- ◇ "D.O.T. SURVEY MARKER NEARBY" SIGN SET

Survey Monument Record

TYPE OF MONUMENT 3/4" X 24" IRON BAR SET

CORNER NO. 53
SECTION 07
TOWN 2N
RANGE 1W

FIELD BOOK: 97-26
PAGE (7)

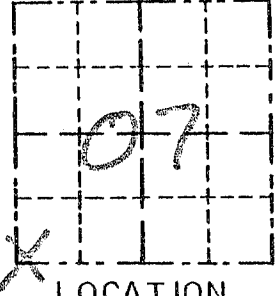


BASIS FOR MONUMENT LOCATION

(Use reverse side if necessary)

Show info such as: History of corner, with reference to Vol. and pg., dates, surveyor; exact description of monument replaced; if location computed, by taped or EDM traverse; landowner, remarks, etc.

SEAL:

CORNER SET IN 1832 BY LUCIUS LYON. NO RECORD OF CORNER FOUND SINCE ORIGINAL SURVEY; CORNER WAS SET AT A OCCUPIED FENCE CORNER VERIFIED ITS LOCATION USING EDM METHODS.

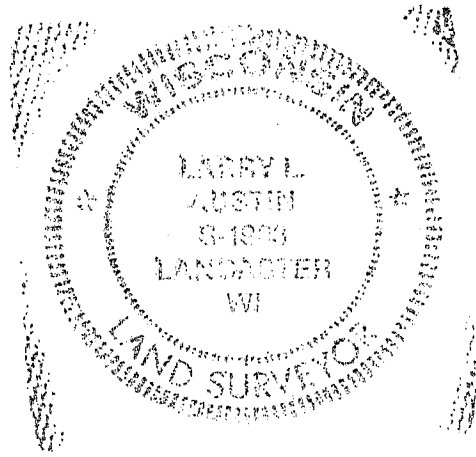

CERTIFIED CORRECT

Larry L. Justin
Registered Land Surveyor


DATE: 1-16-98

TIE SKETCH

Show at least three (3) ties and monument

LEGEND

- 3/4" X 24" IRON BAR SET
- 1/2" X 15" IRON BAR
- XX EXISTING FENCE

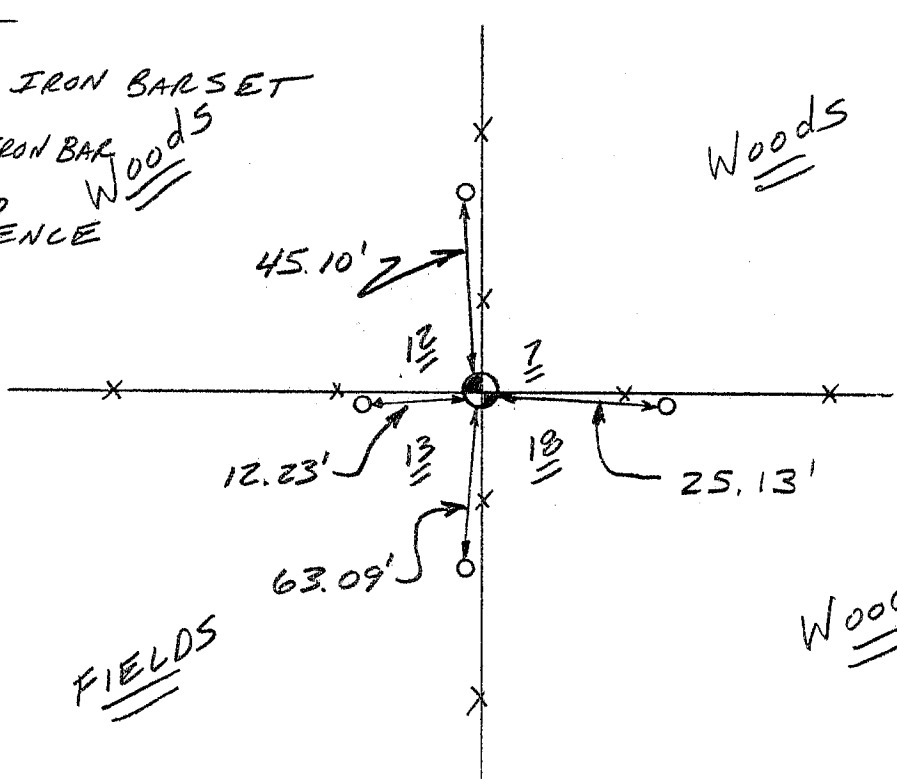

NO SCALE