

U.S. PUBLIC LAND SURVEY MONUMENT RECORD



STATE OF WISCONSIN )  
 COUNTY OF GRANT ) S.S.

CERTIFICATE

I, Laurence E. Schmit certify that the corner location shown on this record was determined by me or under my direction and control and that this U.S. Public Land Survey Monument Record is correct to the best of my knowledge and belief.

Laurence E. Schmit

date Jan. 1983

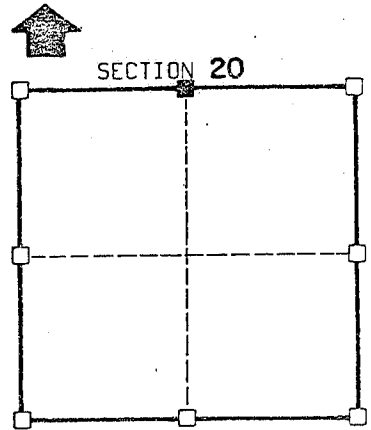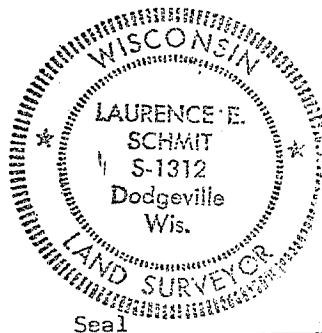

■ = corner location

T 2 N R 1 W

Town of: SMELSER

History of original corner establishment: No written records available since the original survey according to the Grant County abstract office

Description of corner evidence found: Corner located in the N-S fenceline by single proportionate measurement between the NE and NW section corners.


Description of corner and witness monuments, references and accessories used to perpetuate the original or re-established location of this corner:

Witnesses to corner location:

Bruce Bowden R.L.S.

James Olson R.L.S.

Sketch:

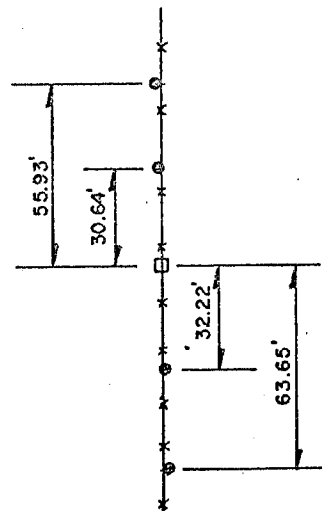

Legend

- NO. 10 REBAR
- NO. 5 REBAR
- x-x-x- FENCELINE

SURVEY CONTROL ORDER

Horizontal

Vertical

WISCONSIN COORDINATE SYSTEM

Corner	East(X)	North(Y)	Elevation(Z)	Zone
Control Sta. Name				

270