


Survey Monument Record

TYPE OF MONUMENT 3/4" X 24" IRON
BAR SET WITH ALUM. CAP

CORNER NO. 88
 SECTION 28
 TOWN 2N
 RANGE 1W

FIELD BOOK: 97-14
 PAGE 9

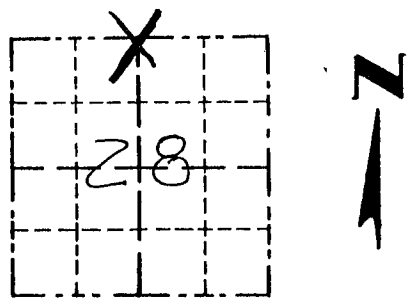

LOCATION
 (Indicated by "X")

BASIS FOR MONUMENT LOCATION

(Use reverse side if necessary)
 Show info such as: History of corner, with reference to Vol. and pg., dates, surveyor; exact description of monument replaced; if location computed, by taped or EDM traverse; landowner, remarks, etc.

SEAL:

CORNER SET IN 1832 BY LUCIUS LYON. NO RECORD OF CORNER FOUND SINCE ORIGINAL SURVEYS; CORNER WAS SET AT AN OCCUPIED FENCE CORNER. VERIFIED THIS LOCATION USING EDM METHODS.



CERTIFIED CORRECT
Larry L. Austin
 Registered Land Surveyor
 DATE: 10-29-98

TIE SKETCH

Show at least three (3) ties and monument

LEGEND

- 3/4" X 24" IRON BAR W/ CAP
- 1/2" X 15" IRON BAR SET
- xx EXISTING FENCE

