


GRANT COUNTY

Survey Monument Record

TYPE OF MONUMENT ALUMINUM MONUMENT
 STATE PLANE COORDINATES: N _____
 E _____
 ELEVATION — M.S.L. DATUM: _____
 THETA ANGLE: _____
 FIELD BOOK: 9411
 PAGE _____

CORNER NO. 116
 SECTION 32
 TOWN 2N
 RANGE 1W
E 1/4 Cor.

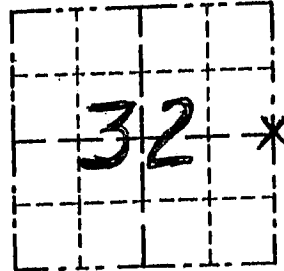

LOCATION
 (Indicated by "X")


BASIS FOR MONUMENT LOCATION

(Use reverse side if necessary)

Show info such as: History of corner, with reference to Vol. and pg., dates, surveyor; exact description of monument replaced; if location computed, by taped or EDM traverse; landowner, remarks, etc.

CORNER WAS ORIGINALLY SET IN 1832 BY LUCIUS LYON; NO RECORD OF CORNER FOUND SINCE THEN, I SET THE CORNER MIDWAY & ON-LINE BETWEEN THE NE CORNER & THE SE CORNER.

SEAL:

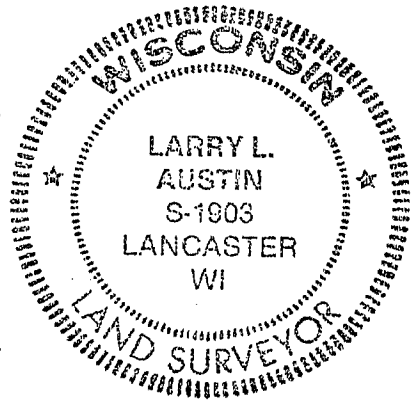


CERTIFIED CORRECT

Larry L. Austin
 Registered Land Surveyor
 DATE: 2/4/95

TIE SKETCH

Show at least three (3) ties and monument

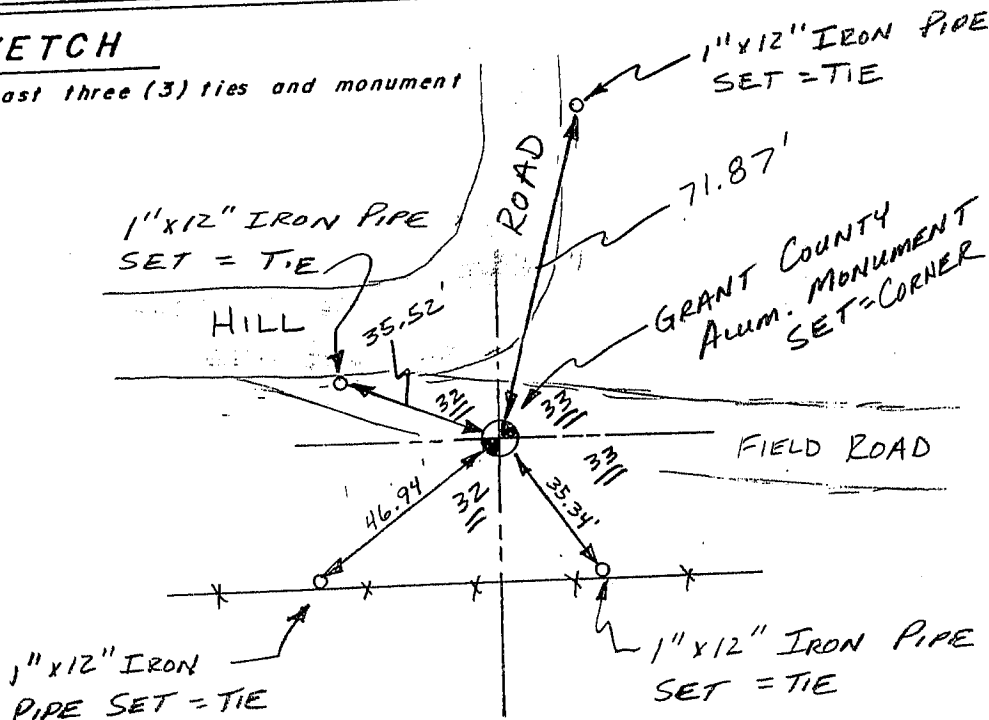

No SCALE