


GRANT COUNTY

Survey Monument Record

TYPE OF MONUMENT 3/4" X 24" IRON BAR
 STATE PLANE COORDINATES: N _____
 E _____
 ELEVATION — M.S.L. DATUM: _____
 THETA ANGLE: _____
 FIELD BOOK: 9409
 PAGE _____

CORNER NO. 118
 SECTION 35
 TOWN 2N
 RANGE 1W

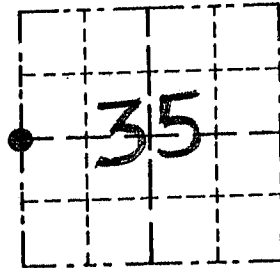

LOCATION
 (Indicated by "•")


BASIS FOR MONUMENT LOCATION

(Use reverse side if necessary)

Show info such as: History of corner, with reference to Vol. and pg., dates, surveyor; exact description of monument replaced; if location computed, by taped or EDM traverse; landowner, remarks, etc.

SEAL:

No RECORD OF CORNER FD.
 SINCE ORIG. SURVEYS; I
 ACCEPTED N-S LOCATION AS
 C/2 OF ROAD & OCCUPATION FOR
 E-W LOCATION; THIS LOCATION
 FITS THE OTHER CORNERS IN
 THE AREA WELL; VERIFIED BY
 EDM TRAVERSE

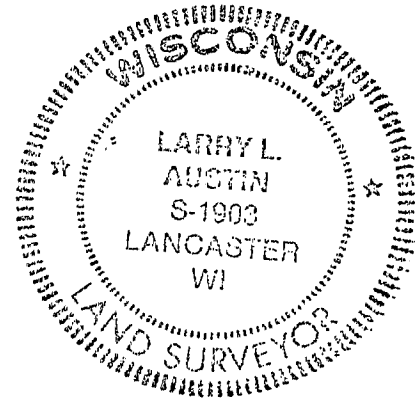


CERTIFIED CORRECT

Larry L. Austin
 Registered Land Surveyor

DATE: 10/7/94

TIE SKETCH

Show at least three (3) ties and monument

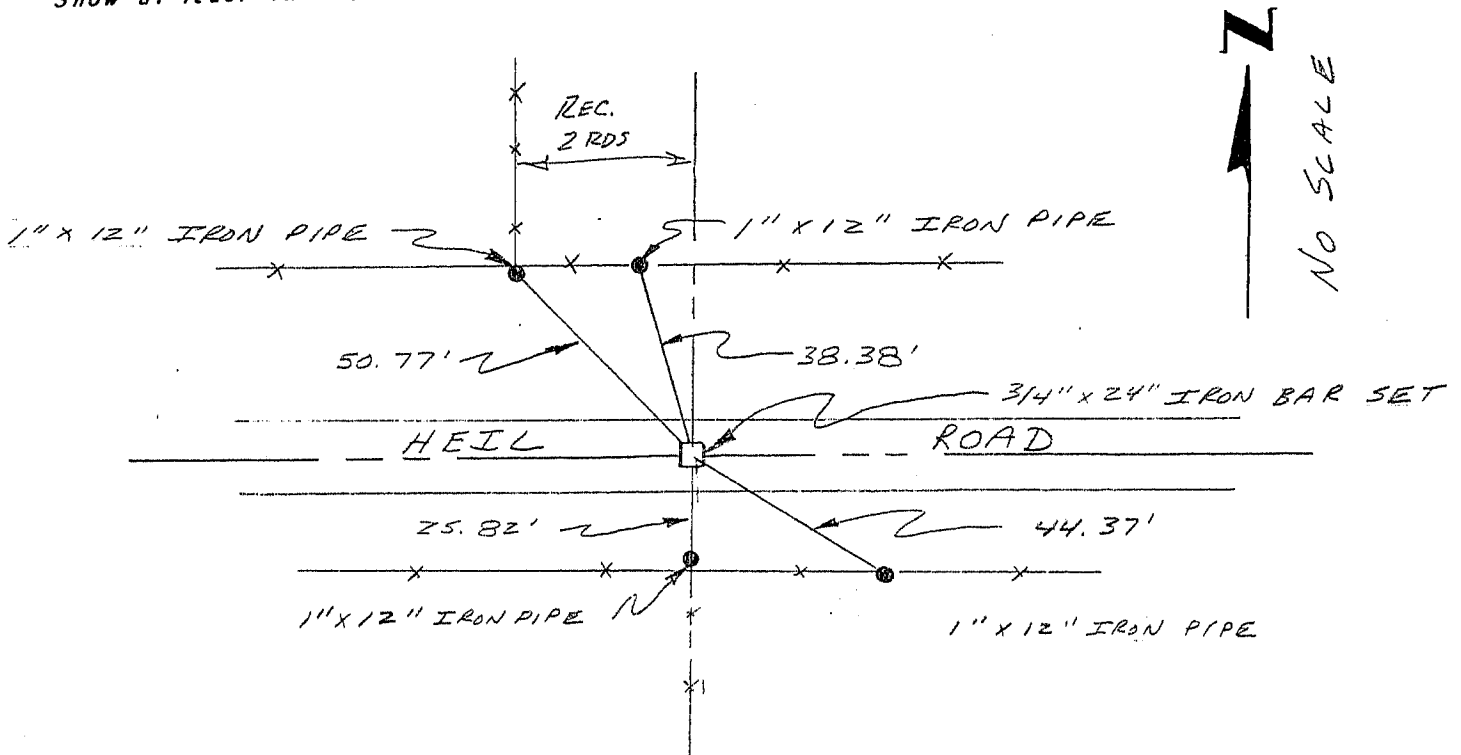

NO SCALE