


GRANT COUNTY

Survey Monument Record

TYPE OF MONUMENT 3/4" X 24" IRON BAR SET
 STATE PLANE COORDINATES: N _____
 E _____
 ELEVATION — M.S.L. DATUM: _____
 THETA ANGLE: _____
 FIELD BOOK: 95-03
 PAGE 30

CORNER NO. 128
 SECTION 33
 TOWN 2N
 RANGE 1W

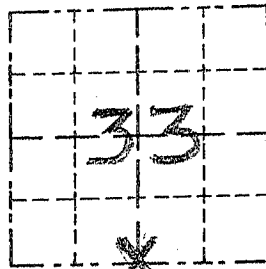

LOCATION
 (Indicated by "X")


BASIS FOR MONUMENT LOCATION

(Use reverse side if necessary)

Show info such as: History of corner, with reference to Vol. and pg., dates, surveyor; exact description of monument replaced; if location computed, by taped or EDM traverse; landowner, remarks, etc.

No RECORD FOUND OF CORNER SINCE ORIGINAL SURVEYS. I SET THE CORNER AT OCCUPIED LOCATION AFTER VERIFICATION BY PROPORTIONATE MEAS. TO OTHER CORNERS IN THE AREA. EDM TRAVERSE USED

SEAL:

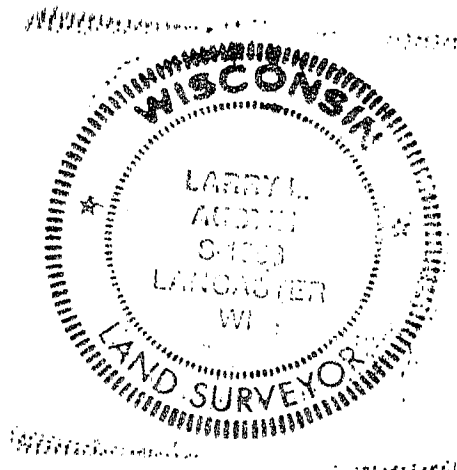


CERTIFIED CORRECT

Larry L. Adams
 Registered Land Surveyor

DATE: 8/15/95

TIE SKETCH

Show at least three (3) ties and monument

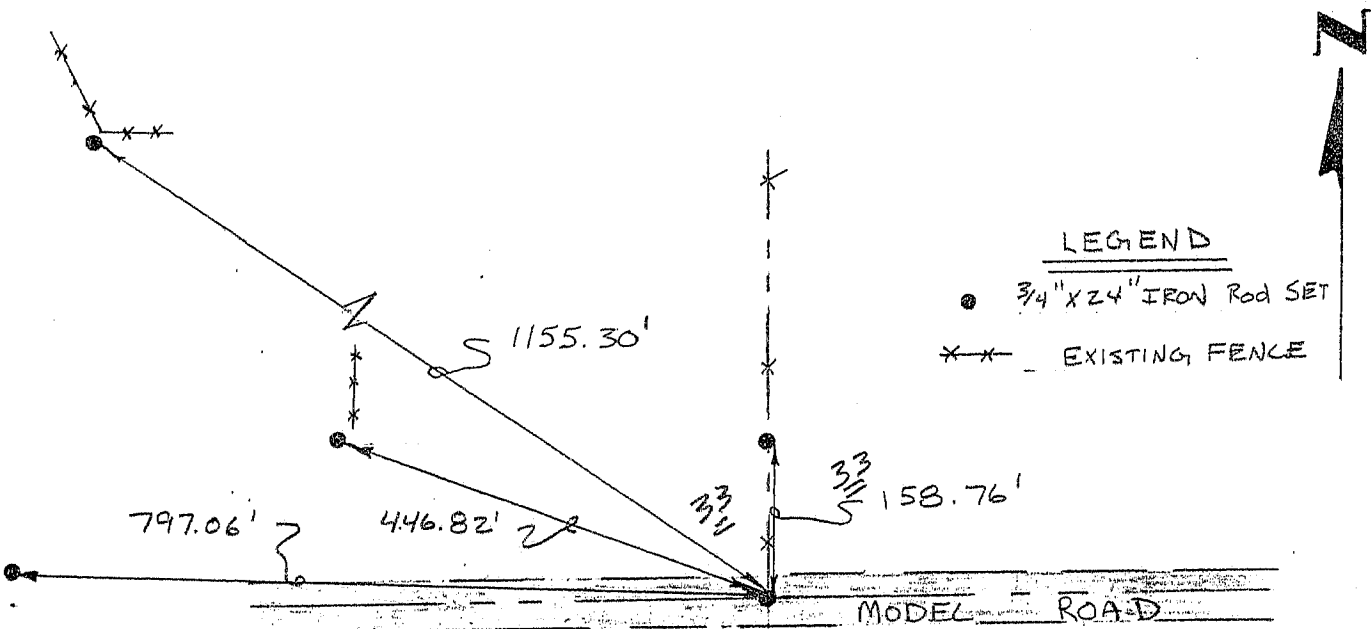

No SCALE