


# GRANT COUNTY

## Survey Monument Record

TYPE OF MONUMENT 3/4" IRON BAR FOUND  
 STATE PLANE COORDINATES: N \_\_\_\_\_  
 E \_\_\_\_\_  
 ELEVATION — M.S.L. DATUM: \_\_\_\_\_  
 THETA ANGLE: \_\_\_\_\_  
 FIELD BOOK: 9411  
 PAGE \_\_\_\_\_

CORNER NO. 129  
 SECTION 32  
 TOWN 2 N  
 RANGE 1 W  
SE COR

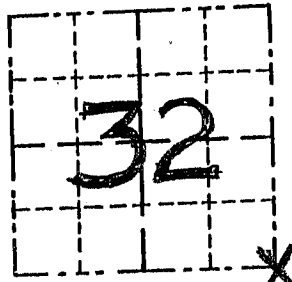

LOCATION  
 (Indicated by "X")




### BASIS FOR MONUMENT LOCATION

(Use reverse side if necessary)

Show info such as: History of corner, with reference to Vol. and pg., dates, surveyor; exact description of monument replaced; if location computed, by taped or EDM traverse; landowner, remarks, etc.

SEAL:

NO RECORD OF CORNER FOUND SINCE ORIG. SURVEYS; FOUND A 3/4" SOLID BAR AT OCCUPIED LOCATION, & ACCEPTED ITS LOCATION AFTER EDM TRAVERSE OF THE AREA

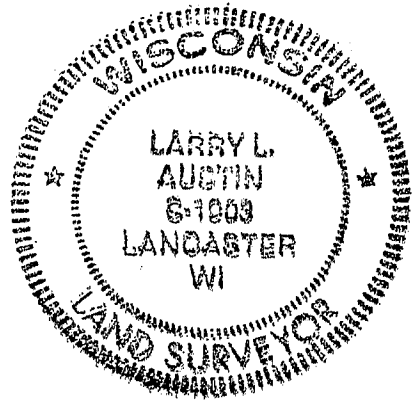

CERTIFIED CORRECT

Larry L. Austin  
 Registered Land Surveyor

DATE: 2/4/95

### TIE SKETCH

Show at least three (3) ties and monument

#### LEGEND

- 3/4" IRON BAR FD. = CORNER
- 1" x 1/2" IRON PIPE
- SET = TIE
- \*—\*— EXISTING FENCE

