


GRANT COUNTY

Survey Monument Record

TYPE OF MONUMENT 3/4" IRON BAR
 STATE PLANE COORDINATES: N _____
 E _____
 ELEVATION — M.S.L. DATUM: _____
 THETA ANGLE: _____
 FIELD BOOK: _____
 PAGE _____

CORNER NO. 131
 SECTION 32
 TOWN 2 N
 RANGE 1 W
SW COR

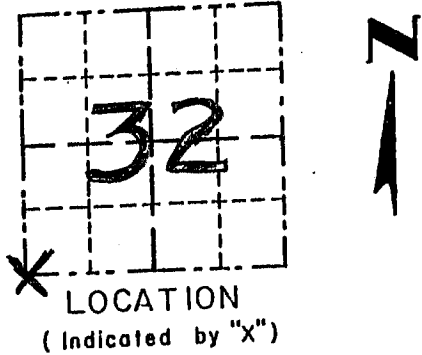


BASIS FOR MONUMENT LOCATION

(Use reverse side if necessary)

Show info such as: History of corner, with reference to Vol. and pg., dates, surveyor; exact description of monument replaced; if location computed, by taped or EDM traverse; landowner, remarks, etc.

SEAL:

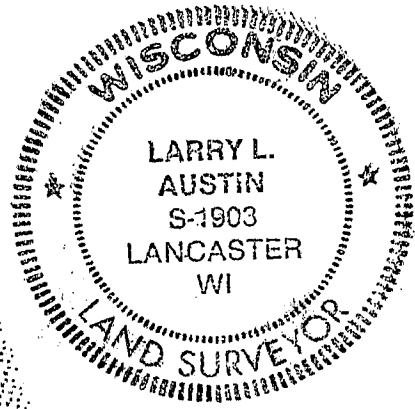


CORNER ORIG SET BY LUCIUS LYON - 1832; NO RECORD OF CORNER FOUND SINCE THE ORIGINAL SURVEYS; I SET THE CORNER AT OCCUPIED LOCATION & VERIFIED BY EDM TRAVERSE OF THE AREA.

CERTIFIED CORRECT

Larry L. Austin
 Registered Land Surveyor
 DATE: 2/5/95

TIE SKETCH

Show at least three (3) ties and monument

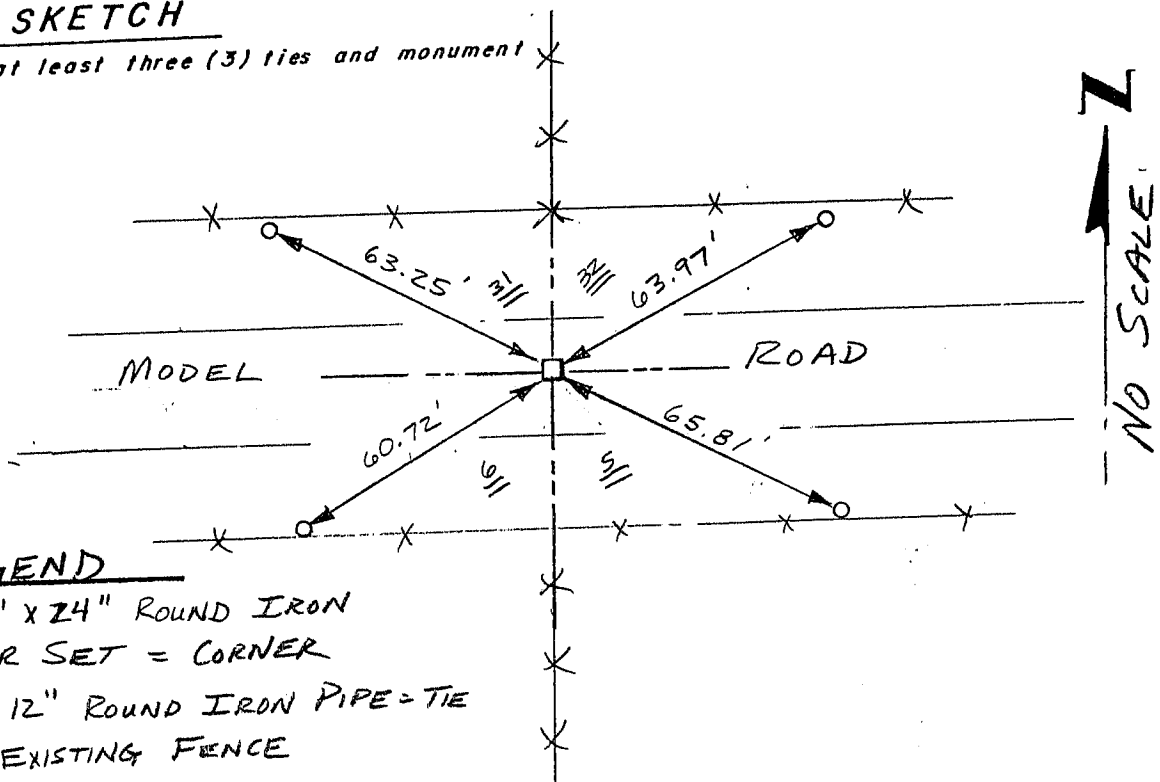

LEGEND

- 3/4" x 24" ROUND IRON BAR SET = CORNER
- 1" x 12" ROUND IRON PIPE = TIE
- X — EXISTING FENCE