

GRANT COUNTY CERTIFIED LAND CORNER


CORNER NUMBER 133

CERTIFICATE:

I, LARRY L. AUSTIN, DO HEREBY CERTIFY THAT ON 6TH DAY OF SEPTEMBER, 1999, I FOUND OCCUPATIONAL EVIDENCE OF THE SOUTHWEST CORNER SECTION 31, TOWN 2 NORTH, RANGE 1 WEST, OF THE FOURTH PRINCIPAL MERIDIAN, AND I RE-ESTABLISHED SAID CORNER ACCORDING TO THE WISCONSIN STATUTES AS SHOWN AND DESCRIBED HEREON.

DATED THIS 17TH DAY OF SEPTEMBER, 1999

Larry L. Austin
LARRY L. AUSTIN S-1903

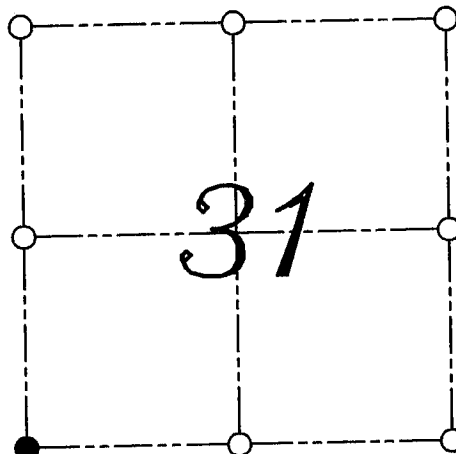

● = CORNER LOCATION
SOUTHWEST CORNER OF SECTION 31, T 2 N R 1 W TOWN OF SMELSER

HISTORY OF ORIGINAL CORNER ESTABLISHMENT:

CORNER WAS SET IN 1832 BY LUCIUS LYON.

DESCRIPTION OF CORNER EVIDENCE FOUND:

I FOUND AN EAST-WEST FENCE WITH DOUBLE BRACE POSTS. I ACCEPTED THIS LOCATION AFTER AN E.D.M. AND G.P.S. TRAVERSE IN ALL DIRECTIONS OF THE CORNER.

DESCRIPTION OF CORNER AND WITNESS MONUMENTS, REFERENCES AND ACCESSORIES USED TO PERPETUATE THE ORIGINAL OR RE-ESTABLISHED LOCATION OF THIS CORNER:
WITNESS TO THE CORNER LOCATION: BOBBY SEDGWICK ; SHELBY BLINDERT

SKETCH:

