


U.S. PUBLIC LAND SURVEY MONUMENT RECORD – GRANT COUNTY, WI


Summary of Section 28, Town 2 North, Range 1 West, Town of Smelser

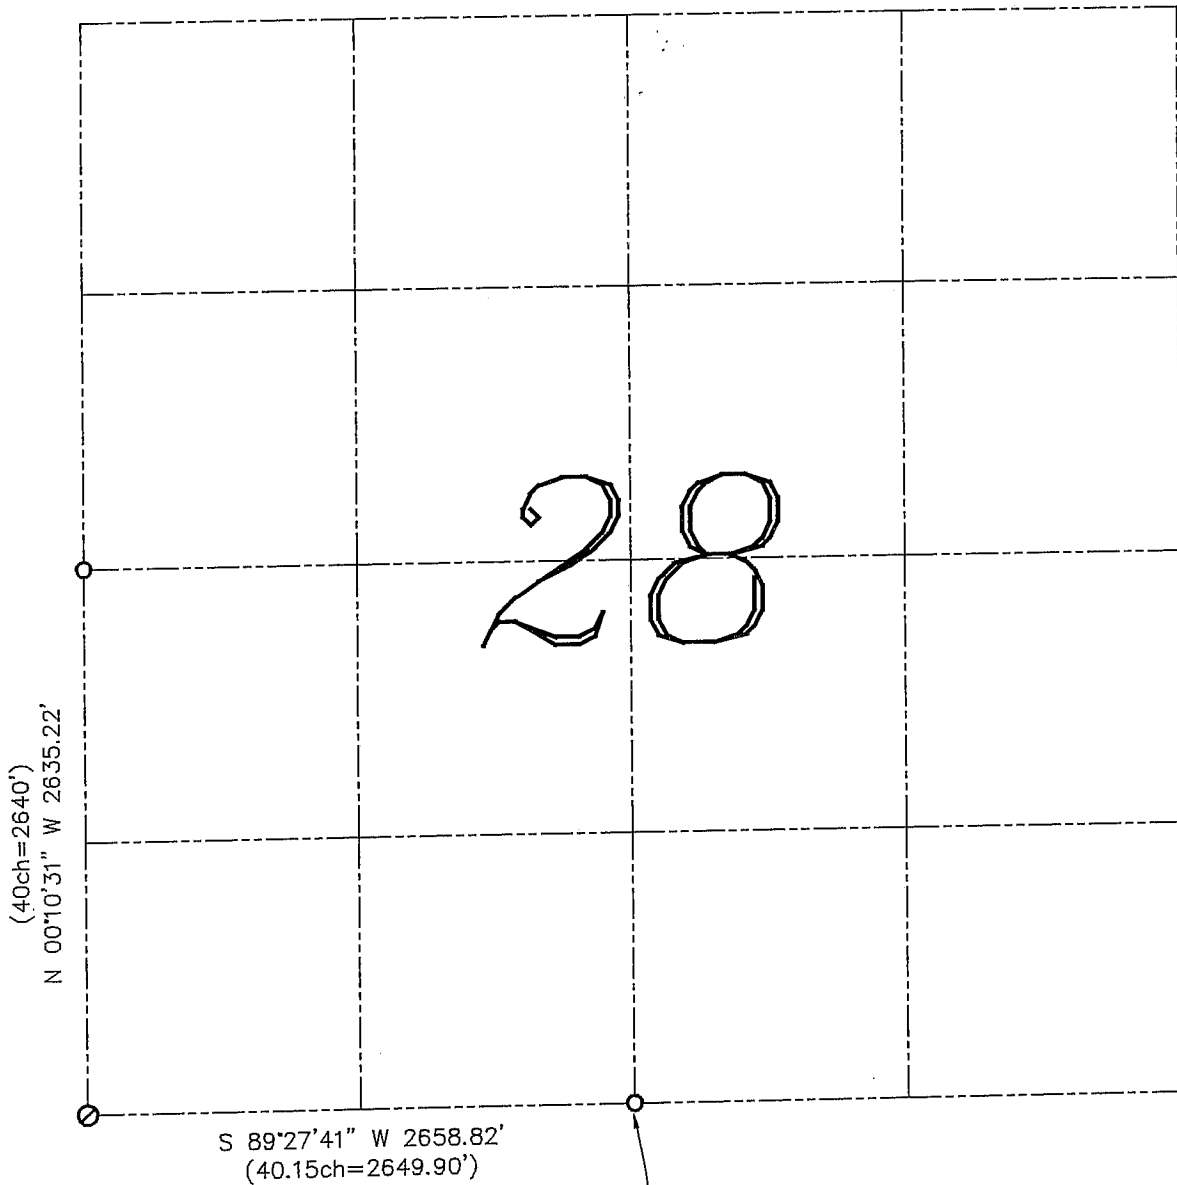

Monument is below road surface.
 The highway department set a PK nail
 at the highway surface. Ties are to
 be used for true monument location.

Relationship of all section corners to other
 section corners shall be shown hereon by bearing
 and distance or grid coordinates. Bearing
 reference shown below.

Dated this 14th day of August, 2003

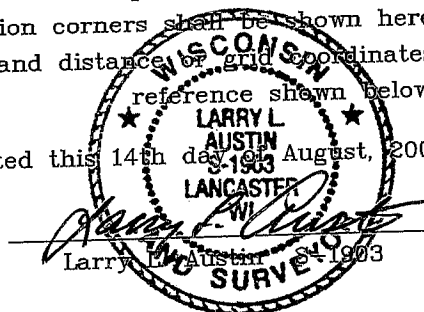

Bearings referenced to the West line of the
 Southwest Quarter of this Section, which is
 assumed to bear as shown hereon.

LEGEND

- No. 6 rebar found
- ⊙ PK Nail found
- () Recorded as
- x— Approximate location of existing fence

SKETCH NOT TO SCALE

AUSTIN ENGINEERING, LLC
 4211 HWY 81 EAST, LANCASTER, WI 53813
 PHONE 608-723-6363 FAX 608-723-6702

FIELDBOOK: TDSR, 2311
 G: \T2NR1W\17
 H: \TIE\T2NR1W\28SUM

CREW: BS-SB-SA-BD
 DRAWN BY: SW AUSTIN
 APPROVED: LL AUSTIN