

# GRANT COUNTY

## Survey Monument Record

TYPE OF MONUMENT ALUM. MONUMENT  
STATE PLANE COORDINATES: N \_\_\_\_\_  
E \_\_\_\_\_  
ELEVATION — M.S.L. DATUM: \_\_\_\_\_  
THETA ANGLE: \_\_\_\_\_  
FIELD BOOK: 9320  
PAGE \_\_\_\_\_


CORNER NO. \_\_\_\_\_  
SECTION 5  
TOWN 2 N  
RANGE 2 W

### BASIS FOR MONUMENT LOCATION

(Use reverse side if necessary)


Show info such as: History of corner, with reference to Vol. and pg., dates, surveyor; exact description of monument replaced; if location computed, by taped or EDM traverse; landowner, remarks, etc.

NO RECORD FOUND OF CORNER SINCE ORIGINAL SURVEYS; CORNER WAS SET BASED ON OCCUPATION & VERIFIED BY EDM TRAVERSE.

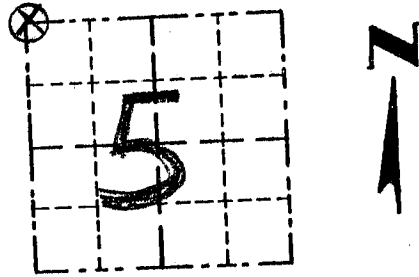

LOCATION  
(Indicated by "X")

SEAL:

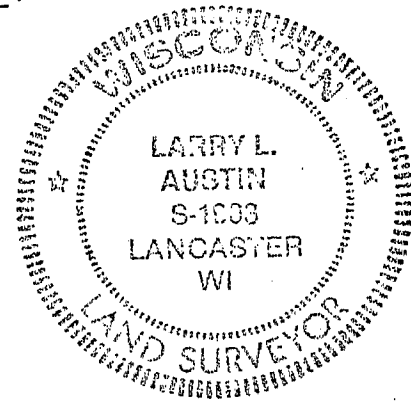

CERTIFIED CORRECT

Larry L. Austin  
Registered Land Surveyor  
DATE: 12/9/93

### TIE SKETCH

Show at least three (3) ties and monument

#### LEGEND

- ALUM MONUMENT
- 3/8" x 12" STEEL SPIKES

X — X FENCE

