

U.S. PUBLIC LAND SURVEY MONUMENT RECORD - GRANT COUNTY, WI

Section 36, Town 2 North Range 2 West, Town of Paris (a)

NOTE: This form is intended and designed to fulfill all requirements of the Wisconsin Administrative Code Chapter A-E 7.08, U.S. Public Land Survey Monument Record (3) (a) (b) (c) (d) (e) (f) (g) (h) (i).


CERTIFICATE: (i)

I, Aaron J. Austin, Wisconsin Professional Land Surveyor, do hereby certify that the corner location on this record was determined by me and/or under my direct supervision and that this U.S. Public Land Survey Monument Record is correct and complete to the best of my knowledge and belief.

Dated this 13th day of June, 2025.

Aaron J Austin

Aaron J. Austin, PLS-2922

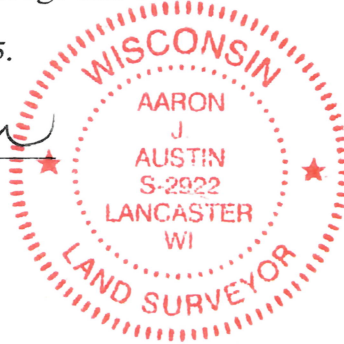

⊙ = CORNER LOCATION

Grant County Coordinates:

NAD 83 (2011)
Northing: 436,692.20
Easting: 861,323.42

HISTORY OF CORNER ESTABLISHMENT:

Original corner was set in 1832 by Lucius Lyon.
Larry Austin set a 3/4" Rebar and prepared a Survey Monument Record dated 11-16-1997.
Stanley King set a D.O.T. Aluminum Monument and prepared a Survey Monument Record dated 1-4-2002.

DESCRIPTION OF CORNER EVIDENCE FOUND: (b) (f) (g) (h)

I found and measured a D.O.T. Aluminum Monument prior to the road construction of County Highway "HH". After the road construction I found the D.O.T. Aluminum Monument and four witness corners undisturbed. I verified the Monument's location with G.P.S. and E.D.M. methods.

DESCRIPTION OF CORNER AND WITNESS MONUMENTS, references and accessories used to perpetuate the original or re-established location of this corner. (c) (d) (e)


Witnesses to corner location Shane Austin.

Drawn by: Owen Austin.

SKETCH:

LEGEND

- ⊙ Section Corner—as designated
- ⊠ D.O.T. Aluminum found
- x-x-x- Existing fence
- () Recorded as

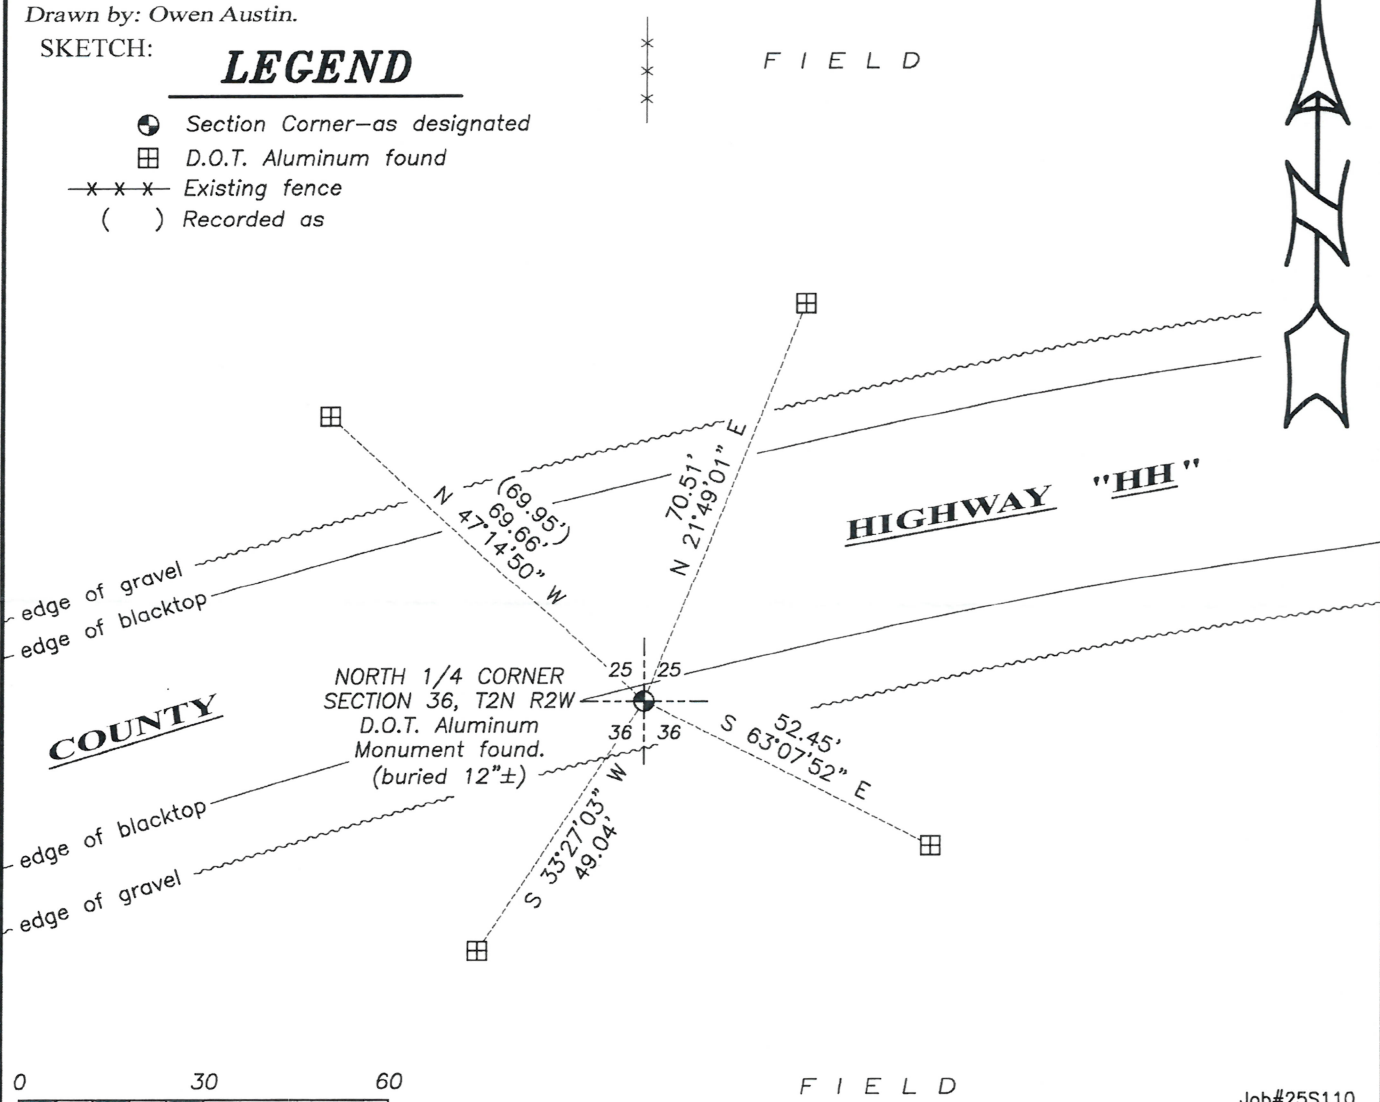

0 30 60

SCALE 1" = 30'

F I E L D

CERTIFIED LAND CORNER


STATE OF WISCONSIN COUNTY OF GRANT

CERTIFICATE

I, Stanley J. King, do hereby certify that the corner location of this record was determined by me and/or under my direct supervision and that this U.S. public land survey monument record is correct and complete to the best of my knowledge and belief.

Dated this 4th day of January, 2002

Stanley J. King
Stanley J. King S-2001

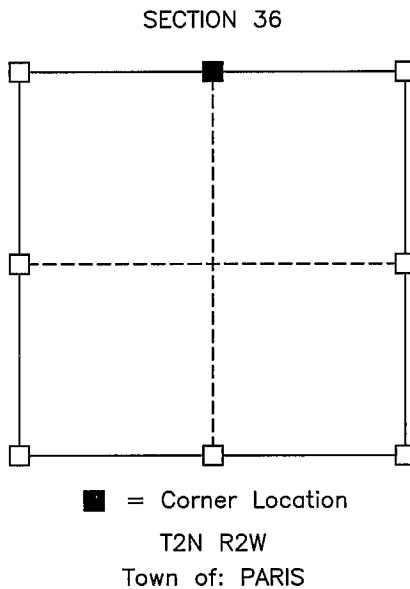

Seal:

History of original corner establishment:

Original corner was set in 1833 by Lucius Lyon.
Corner was reset in 1997 by Larry Austin.

Description of corner evidence found:

Corner was destroyed during re-construction of CTH "HH" in 2001.
Prior to being destroyed, corner was tied off, and replaced to the exact location after construction.

Description of corner and witness monuments, references, and accessories used to perpetuate the original or re-established location of this corner:


Witnesses to corner location:

Stanley J. King
Daniel J. Dreessens
.....
.....

LEGEND

- = SECTION CORNER (WisDOT ALUM. MONUMENT)
- = TIE BAR (WisDOT ALUM. MONUMENT)
- = WisDOT R/W PIN (3/4" BAR FOUND)

- (A-B) = S 33°27'12" W 49.04'
- (A-C) = S 63°08'56" E 52.45'
- (A-D) = N 21°49'27" E 70.51'
- (A-E) = N 47°12'22" W 69.95'

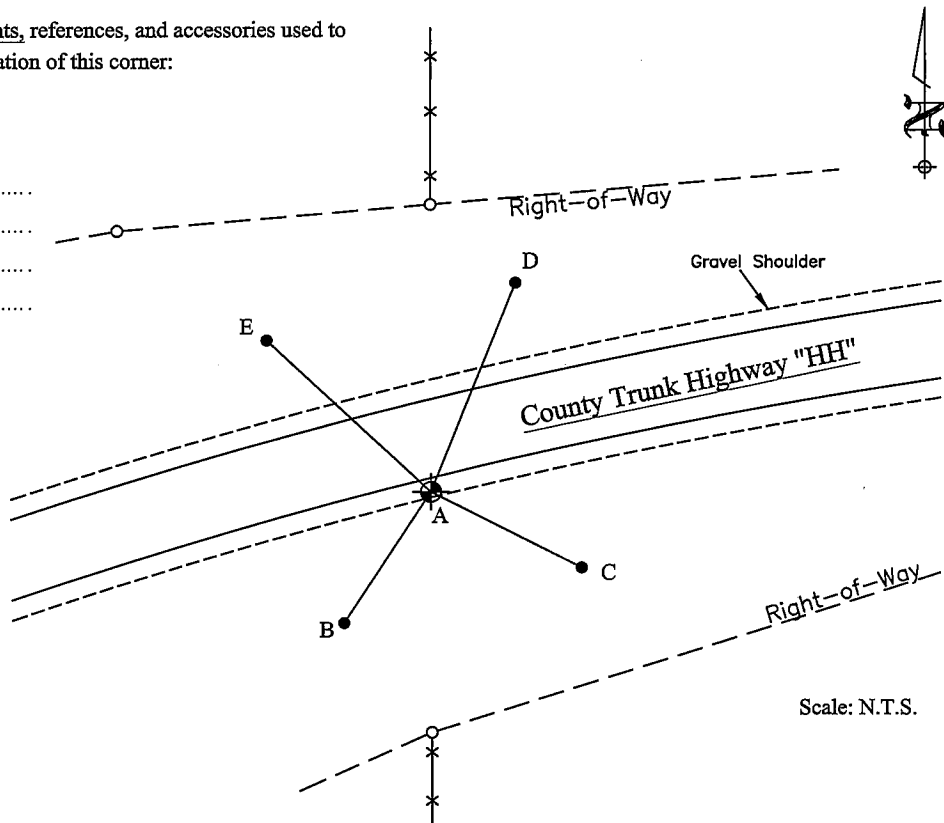

BLACKHAWK
ENGINEERING, Ltd.

Civil & Municipal Engineers and Building Design
2 INSIGHT DRIVE OFFICE PHONE: (608) 348-4433
PLATTEVILLE, WISCONSIN FAX: (608) 348-4449


SURVEY CREW: DJD, SJK
DRAWN BY: DJD
DATE: JAN. 4, 2002
FILE: f:\acad12\2001\01-018\tiesheetnorthcor36.dwg

Survey Monument Record

TYPE OF MONUMENT 3/4" X 24" IRON BAR
SET

CORNER NO. 102
SECTION 25
TOWN 2N
RANGE 7W

FIELD BOOK: 97-01
PAGE _____

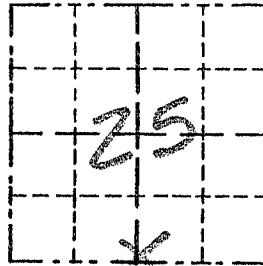


BASIS FOR MONUMENT LOCATION

(Use reverse side if necessary)

Show info such as: History of corner, with reference to Vol. and pg., dates, surveyor; exact description of monument replaced; if location computed, by taped or EDM traverse; landowner, remarks, etc.

LOCATION
(Indicated by "X")

SEAL:

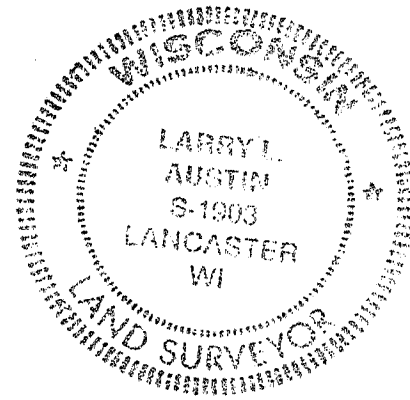

CORNER SET IN 1933 BY LUCIUS LYON. NO SURVEY RECORD OF CORNER FOUND SINCE ORIGINAL SURVEY; CORNER WAS SET ONLINE WITH THE SOUTHWEST AND SOUTHEAST CORNERS ALSO ONLINE WITH A FENCE NORTH/SOUTH; VERIFIED THIS LOCATION USING EDM METHODS.

CERTIFIED CORRECT

Larry L. Austin
Registered Land Surveyor

DATE: 11-16-97

TIE SKETCH

Show at least three (3) ties and monument

LEGEND

- ⊙ 3/4" X 24" IRON BAR SET
- 1/2" X 15" IRON BAR SET
- EXISTING FENCE

