


Section Summary

GRANT COUNTY

03 - 2N - 2W  
SECTION TOWN RANGE

W CORNER  
5L 03

N 1/4 CORNER  
2ER. 03

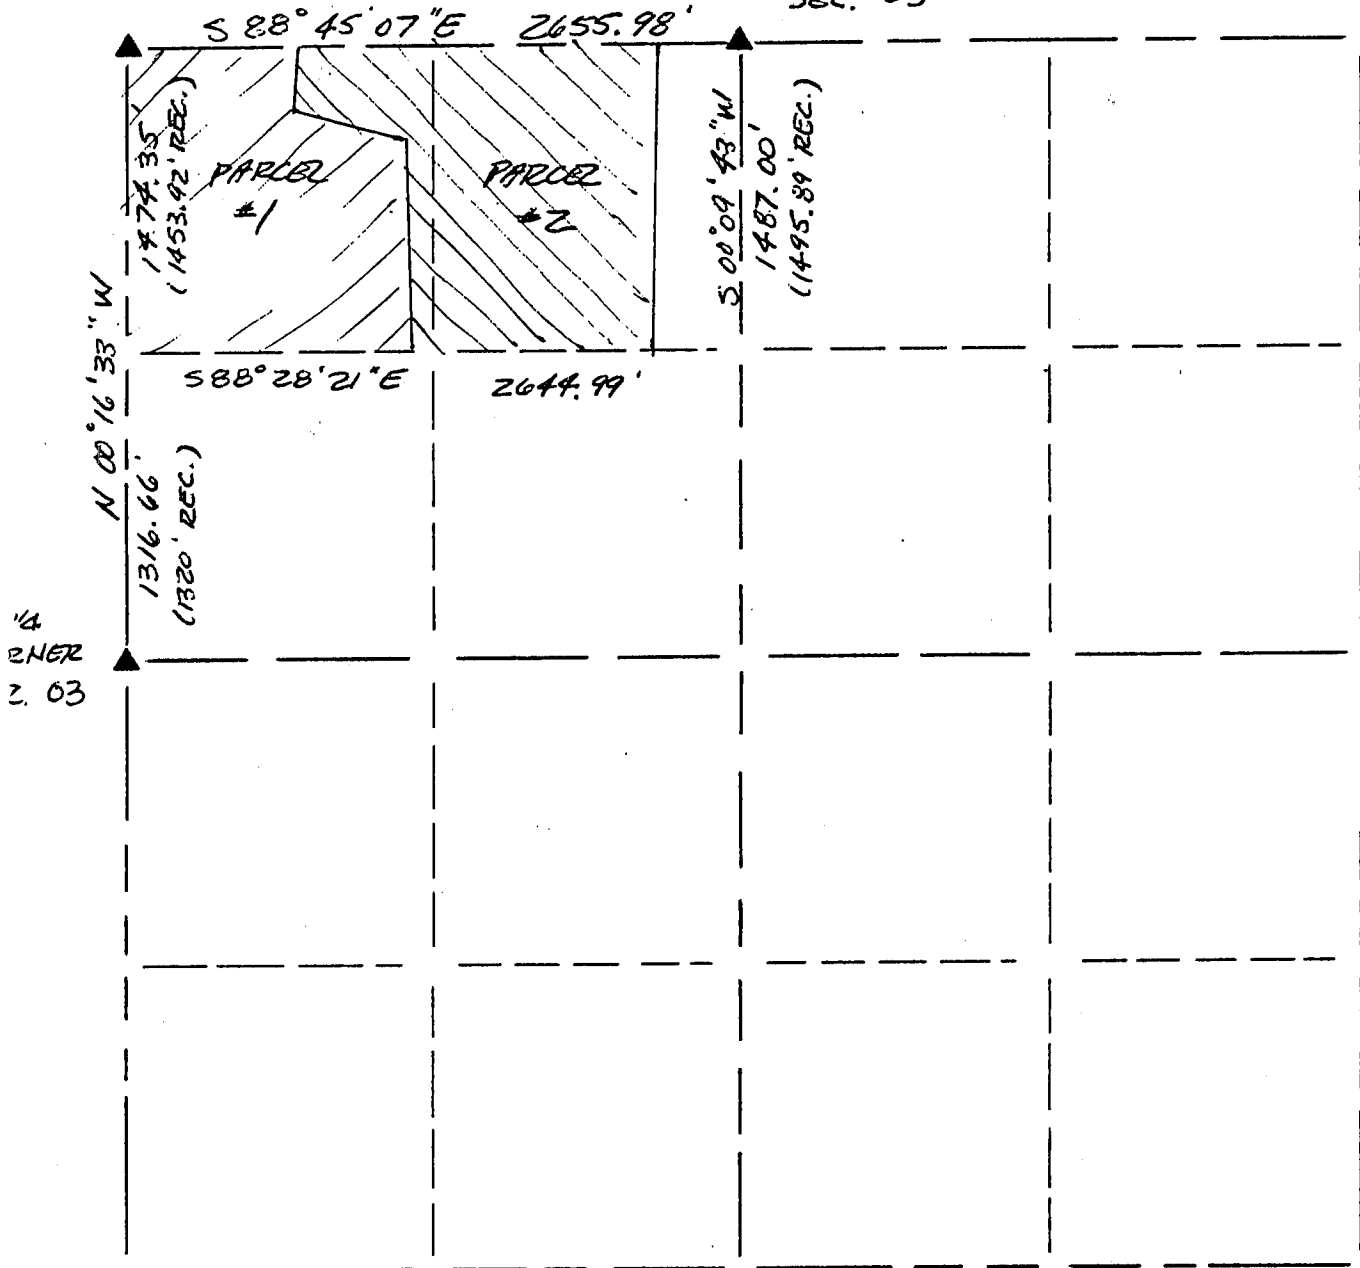

LEGEND

- △ COUNTY MONUMENT
- STONE OR CONCRETE MONUMENT
- OTHER (specify) \_\_\_\_\_
- ▲ SET #6 BAR

NOTE:

Relationships of all section corners to other section corners shall be shown hereon by bearing and distance or grid coordinates

Show or describe bearing reference

4/349