

CERTIFIED LAND CORNER RESTORATION

State of Wisconsin
County of Grant

Little Platte River

Reference Monument
N 30-08-05 W
139.07'

600.6'

Burr Oak Stump
w/ wire

2639.79'
5279.58' (5280)

"Logging Line"

T2N R2W

2639.79'
N 1-11-39 E

N 88-52-13 E

5325.29' (5325.54')

N 89-28-19 E 2662.86'
(2663.10')


N 88-16-07 E 2662.73'
(2662.44')

5294.76' (5280)
2642.38'

T2N R2W

12

S 0-35-33 W
205.44'
Reference Monument

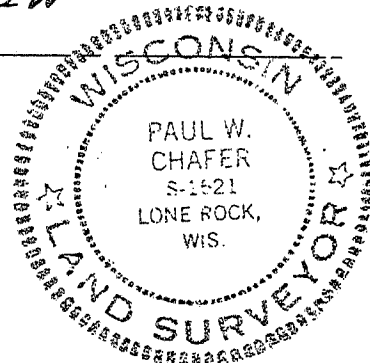

MAY 21 1985

N 0-25-38 E
2647.38'

I Paul W. Chafer do hereby certify that on the 7th day of December, 1984, I found evidence of the following corners in Sections 1 and 12, T 2 N, R 2 W, Fourth Principal Meridian, as hereon shown.

Signature *Paul W. Chafer*
Title Registered Land Surveyor
Surveyors Registration No. S-1521