

U. S. PUBLIC LAND SURVEY MONUMENT RECORD

INSTRUCTIONS : This record shall show the location of the corner and shall include all of the following nine elements (a through i).


- (a) Identify the corner by reference to the U.S. public land survey system.
 ● = Corner monument restored.

N1/4 Corner of Section 6

T 2 N R 3 W

Town of Potosi (South Part)

Grant Co., Wis.

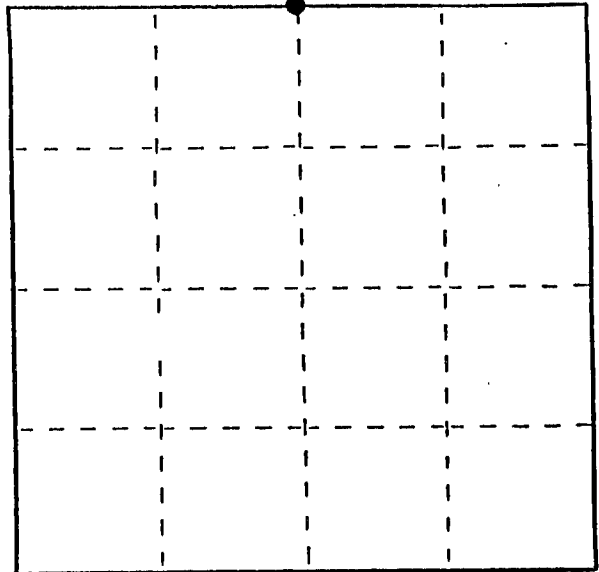

Section 6 T2N R3W


- (b) Describe any record evidence, monument evidence, occupational evidence, testimonial evidence or any other material evidence you considered, and whether the monument was found or placed.

Originally set by Lucius Lyon in the 1st 1/4 of 1833. A survey of the East 1/2 of Section 1 T2N R4W, and the West 1/2 of this Section was done, dated Feb. 22nd, 1856 unsigned. Only identification is initials "J.B.". This gives no dimensions, and the bearing tree, a 24" White Oak, is not to be found, or evidence thereof. The railroad tie fence corner was placed by Jerome Reding, longtime owner and resident, who states it is correct. EDM traverse indicates this is the best location.

- (c) In the plan view drawing below, provide reference ties to at least 4 witness monuments, or, if the location is within a municipality, to at least 2 witness monuments. (Witness monuments shall be made of concrete, natural stone, iron or other equally durable material.) Describe witness monuments.

- (d) Show a plan view drawing depicting the relevant monuments and reference ties which is sufficient in detail to enable accurate relocation of the corner monument if the corner monument is disturbed. Indicate north.

Scale: 1" = 30'

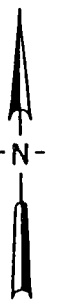

(Bearings shown are for orientation purposes only)

60# Spikes set in blazed trees
(spikes in Base)


62.40'
3/4" Rebar set

10" Poplar
N14°E 33.02'

8" Maple
S65°E 43.46'

20" White Oak
S40°W 38.88'

Corner is Wis. Dept. of Transportation
2" X 30" aluminum monument
(with sign and post)

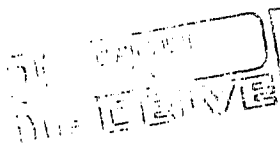

SEP 13 1989

p 12

- (e) Describe any material discrepancy between the location of the corner as restored or reestablished and the location of that corner as previously restored or reestablished by distance and direction. Show the discrepancy on the plan view drawing under (d), above. Show the distances between the corner as previously restored or reestablished and (1) the corner as restored or reestablished, and (2) to at least 2 of the witness monuments shown on the drawing in (d), above.

NONE


- (f) Was the corner restored through acceptance of (1) an obliterated evidence location, or, (2) a found perpetuated location?

Obliterated evidence location

- (g&h) Was the corner reestablished through lost corner proportionate methods? If so, show the method, including the directions and distances to other public land survey corners used as evidence or used for proportioning in determining the corner location?

No

Affix Land Surveyor Seal

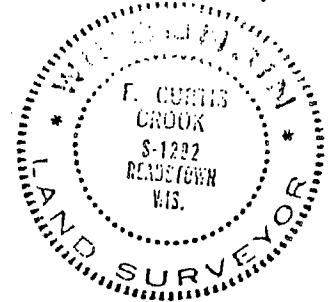

- (1) I, F. Curtis Crook,
(type or print name) certify that the corner location shown
on this record was determined by me or under my direction and
control and that this U.S. Public Land Survey Monument Record is
correct and complete to the best of my knowledge and belief.

F. Curtis Crook

5-25-89