

# U. S. PUBLIC LAND SURVEY MONUMENT RECORD

**INSTRUCTIONS:** This record shall show the location of the corner and shall include all of the following nine elements (a through i).


- (a) Identify the corner by reference to the U.S. public land survey system.  
 ● = Corner monument restored.

SW Corner of Section 4

T 2 N R 3 W

Town of Potosi (South Part)

Grant Co., Wis.

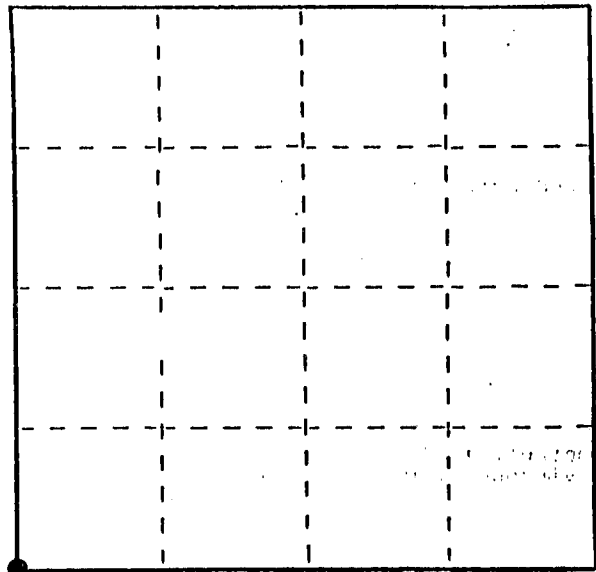

Section 4 T2N R3W



- (b) Describe any record evidence, monument evidence, occupational evidence, testimonial evidence or any other material evidence you considered, and whether the monument was found or placed.

Originally established by Lucius Lyon during 1st 1/4 1833; a survey by Charles Sampson performed in April, 1900 shows the corner 2.58 chains South of the railroad centerline, the railroad map shows 170' South. A survey by Paul Brashaw, RLS, in May of 1984, of a parcel in Section 5 (CSM #218) shows an iron monument at this corner. After extensive searching, survey retracement, etc., Mr. Brashaw (now of Illinois) was reached by telephone. He stated he did not get the corner set, but left a nail in the center of the West bound railroad track (also railroad reference line) on the East line of Section 5. This was located, and corner was set 170.28' (2.58 chains) southerly of this, in line with the West 1/4 corner.

- (c) In the plan view drawing below, provide reference ties to at least 4 witness monuments, or, if the location is within a municipality, to at least 2 witness monuments. (Witness monuments shall be made of concrete, natural stone, iron or other equally durable material.) Describe witness monuments.

- (d) Show a plan view drawing depicting the relevant monuments and reference ties which is sufficient in detail to enable accurate relocation of the corner monument if the corner monument is disturbed. Indicate north.


Scale: 1" = 30'

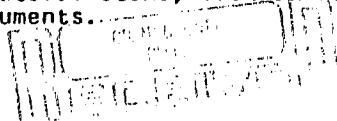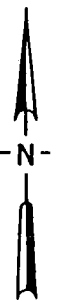

SEP. 13. 1989

(Bearings shown are for orientation purposes only)

60# spike set in base of tree with blaze  
 (all Maples in this case)

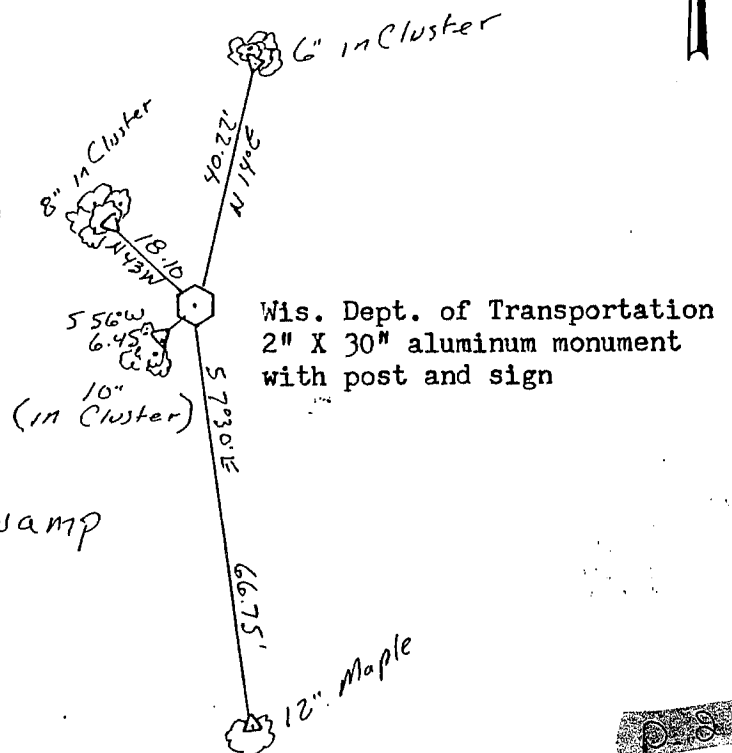

All Swamp



(e) Describe any material discrepancy between the location of the corner as restored or reestablished and the location of that corner as previously restored or reestablished by distance and direction. Show the discrepancy on the plan view drawing under (d), above. Show the distances between the corner as previously restored or reestablished and (1) the corner as restored or reestablished, and (2) to at least 2 of the witness monuments shown on the drawing in (d), above.

none

(f) Was the corner restored through acceptance of (1) an obliterated evidence location, or, (2) a found perpetuated location?

obliterated evidence location

(g&h) Was the corner reestablished through lost corner proportionate methods? If so, show the method, including the directions and distances to other public land survey corners used as evidence or used for proportioning in determining the corner location?

NO

(1) I, F. Curtis Crook  
(type or print name) certify that the corner location shown on this record was determined by me or under my direction and control and that this U.S. Public Land Survey Monument Record is correct and complete to the best of my knowledge and belief.

*F. Curtis Crook* 5-25-89

