

Survey Monument Record

CORNER NO. \_\_\_\_\_  
 SECTION 25  
 TOWN 2N  
 RANGE 3W

TYPE OF MONUMENT CONCRETE W/BRASS CAP


STATE PLANE COORDINATES: N \_\_\_\_\_  
 E \_\_\_\_\_

ELEVATION — M.S.L. DATUM: \_\_\_\_\_

THETA ANGLE: \_\_\_\_\_

FIELD BOOK: \_\_\_\_\_

PAGE \_\_\_\_\_

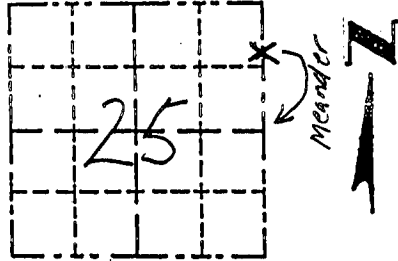

LOCATION  
 (Indicated by "X")

- FOUND PERPETUATED LOCATION
- OBLITERATED EVIDENCE LOCATION
- LOST CORNER (RESTORED BY PROPORTIONATE METHODS)

BASIS FOR MONUMENT LOCATION

(Use reverse side if necessary)

Show info such as: History of corner, with reference to Vol. and pg., dates, surveyor; exact description of monument replaced; if location computed, by taped or EDM traverse; landowner, remarks, etc.

monument was noted in a plat by the U.S. Army Corps of Engineers of the Mississippi River Lock & Dam No. 11 Land Acquisition dated 6/6/1938. The E 1/4 corner is currently under water in the now flooded Platte River. This plat calls for a distance of 1235.1' to the NE corner of 25. We have measured 1235.42'.

STAMPED U.S. ARMY CORPS  
 OF ENGINEERS (1941)  
 INDEX NO. 11FW2981

CERTIFIED CORRECT TO THE BEST  
 OF MY KNOWLEDGE AND BELIEF

*Michael R. LaRosa*

Registered Land Surveyor

DATE: 3/4/1999

TIE SKETCH 1" = 200' +/-

Show at least (4) ties and monument

Legend

△ 1" IRON PIPES FOUND

