

GRANT COUNTY

POTOSI TWP

Section Summary

4 - 2 North - 3 West
SECTION TOWN RANGE

Wis. Coord. System

X= 1800753.06

Y= 249502.17


NW Cor.

RECORD = N90°00'00"W 3972.70'

N89°42'58"W 3972.70'

X 1,806,044.33

Y 249,475.95

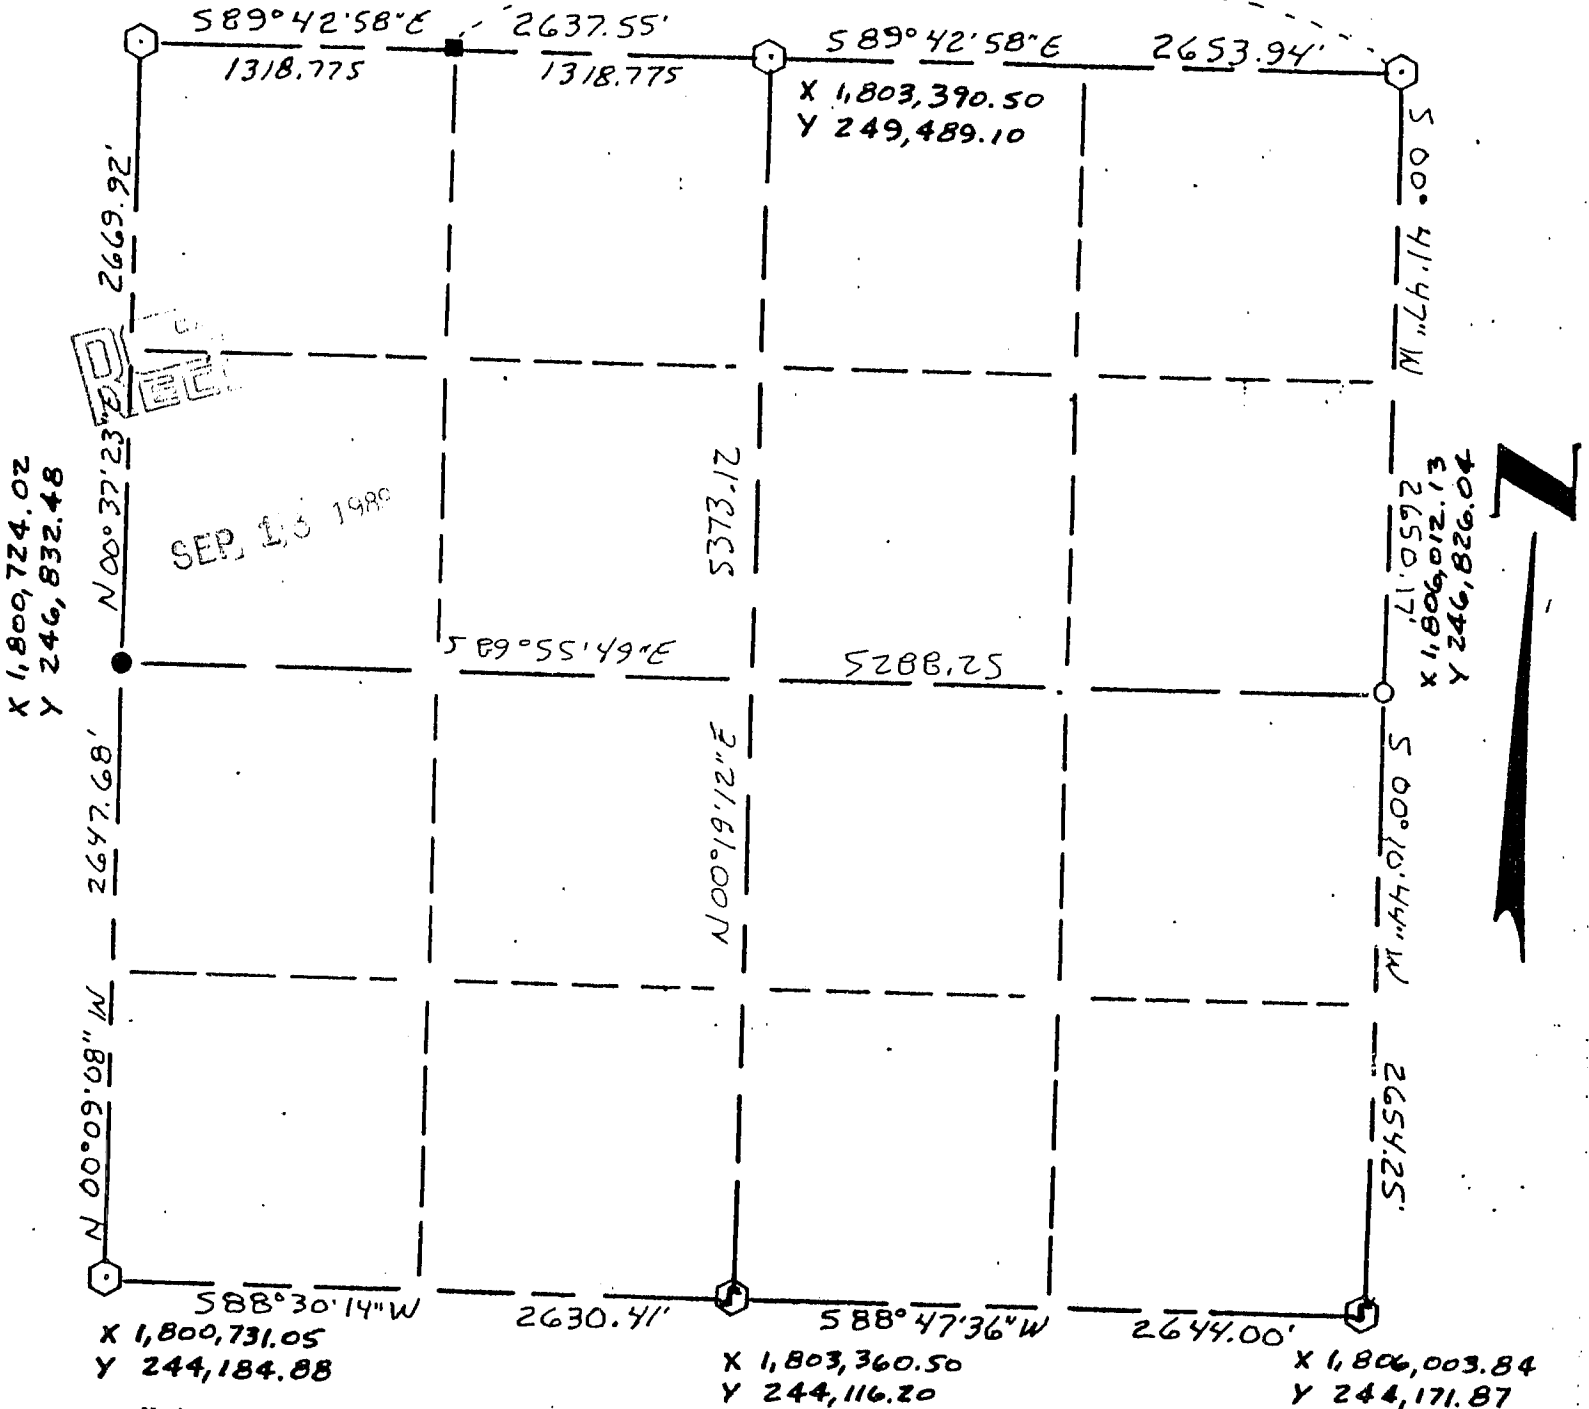

Note: in referring to coordinates on related Sections of this survey, scale factor of .9999739 used.

LEGEND

- △ COUNTY MONUMENT
- STONE ~~CONCRETE~~ MONUMENT (found)
- OTHER (specify) 3/4" Rebar (found)
- 1" Iron Pipe (found)
- ⊕ Railroad Rail Splice (found)
- ⊙ Wis. Dept. of Transportation 2" X 30" Aluminum Monument w/cap (set)

NOTE:

Relationships of all section corners to other section corners shall be shown hereon by bearing and distance or grid coordinates

Show or describe bearing reference Wis. coordinate system, South Zone

F. Curtis Crook RLS #1292
(Readstown Wi., 54652)
608-629-5429

