


Survey Monument Record

TYPE OF MONUMENT 3/4" x 24" IRON BAR

CORNER NO. 05  
 SECTION 03  
 TOWN 2N  
 RANGE 4W

FIELD BOOK: 97-01  
 PAGE (9)

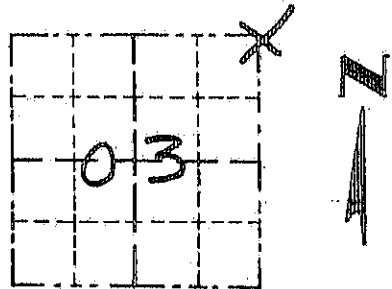

LOCATION  
 (Indicated by "X")


BASIS FOR MONUMENT LOCATION

(Use reverse side if necessary)

Show info such as: History of corner, with reference to Vol. and pg., dates, surveyor; exact description of monument replaced; if location computed, by taped or EDM traverse; landowner, remarks, etc.

SEAL:

CORNER WAS SET IN 1833 BY LUCIUS LYON. IN 1855 BOOK B PAGE 390 THERE WAS A SURVEY DONE IN SECTION 34 T2N R4W. THE SURVEYOR TIED TO THE SOUTHWEST CORNER. IN 1883 J.C. SCOTT TIED TO THE CORNER. HOMER RALPH TIED TO THE CORNER NO MONUMENT PLACED. IN 1989 CURTIS CROOK LOCATED THE CORNER NO MONUMENT PLACED. I RESET THE CORNER BASED ON DISTANCES ON THE 1855 AND THE 1883 SURVEYS WHICH SEEM TO FIT VERY WELL EAST, WEST, NORTH OF THE CORNER, VERIFIED THIS LOCATION USING EDM METHODS.

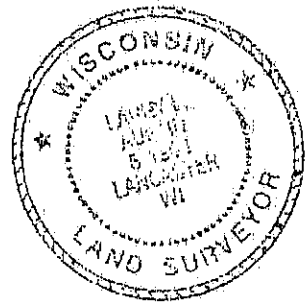

CERTIFIED CORRECT

*Amy J. Rust*  
 Registered Land Surveyor

DATE: 1-8-98

TIE SKETCH

Show at least three (3) ties and monument

