



U.S. PUBLIC LAND SURVEY MONUMENT RECORD – GRANT COUNTY, WI
Section 5, Town 3 North Range 1 West, Town of Platteville

CERTIFICATE

I, Larry L. Austin, do hereby certify that the corner location on this record was determined by me and/or under my direct supervision and that this U.S. public land survey monument record is correct and complete to the best of my knowledge and belief.

Dated this 10th day of March, 2005

Larry L. Austin
 Larry L. Austin

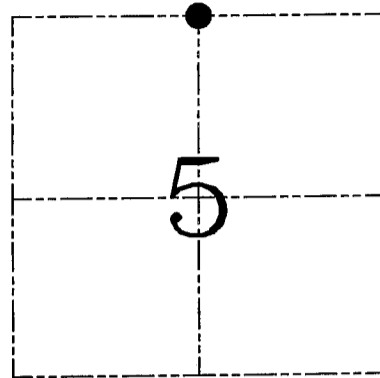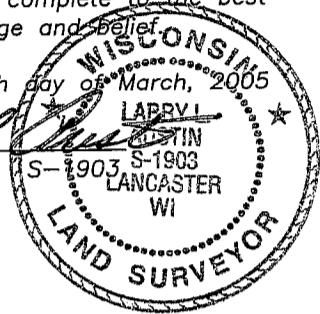

● = CORNER LOCATION

HISTORY OF CORNER ESTABLISHMENT



Corner was originally set in 1891 by Sampson.
 No other record of the corner was found.

DESCRIPTION OF CORNER EVIDENCE FOUND

I set the corner at the recorded offset from the South 1/4 of Section 32, T4N R1W. Verified this location using EDM & GPS methods.

DESCRIPTION OF CORNER AND WITNESS MONUMENTS, references and accessories used to perpetuate the original or re-established location of this corner. Witnesses to corner location Bobby Sedgwick & Shelby Blindert & Brad Digman

SKETCH:

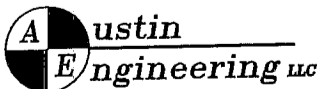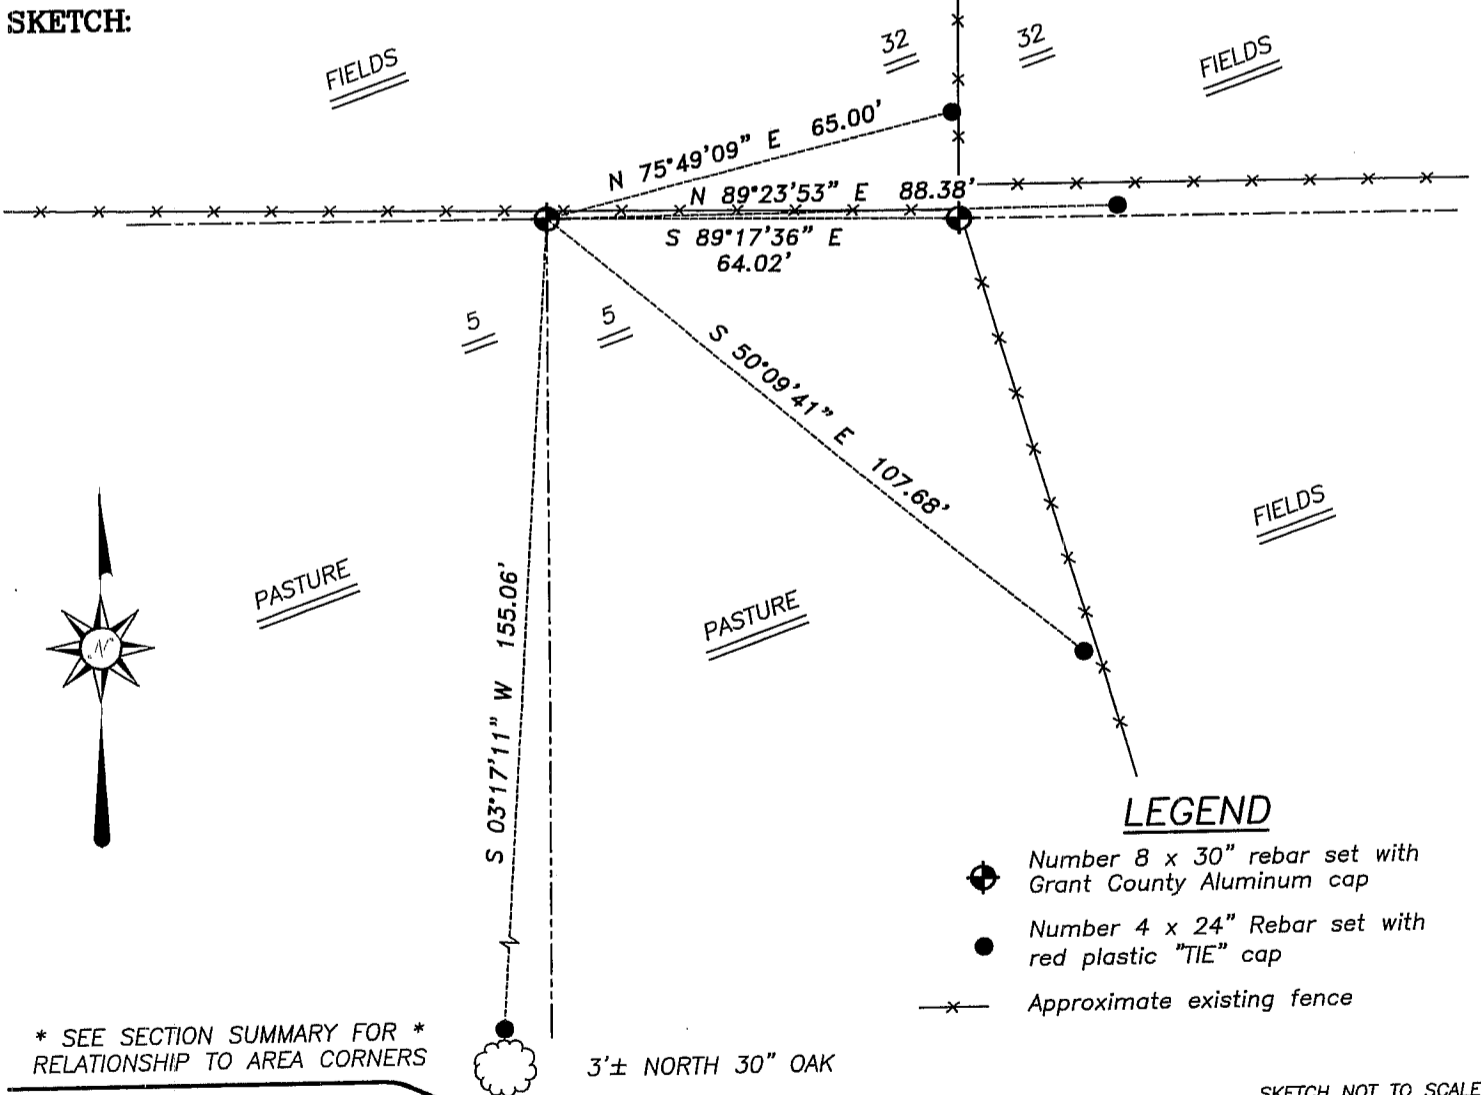

4211 HWY 81 E, LANCASTER, WI 53813
 PHONE 608-723-6363 FAX 608-723-6702

JOB NUMBER 05S023
 FIELDBOOK: TDSR, 2502
 G:\T4NR1W\T4N
 H:\TIE\T3NR1W\10

DRAWN BY: SW AUSTIN
 APPROVED: LL AUSTIN