


GRANT COUNTY

Survey Monument Record

TYPE OF MONUMENT ALUM. MONUMENT
 STATE PLANE COORDINATES: N _____
 E _____
 ELEVATION — M.S.L. DATUM: _____
 THETA ANGLE: _____
 FIELD BOOK: _____
 PAGE _____

CORNER NO. 12
 SECTION 6
 TOWN 3 N
 RANGE 1 W

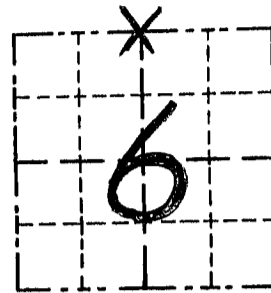

LOCATION
 (Indicated by "X")

BASIS FOR MONUMENT LOCATION

(Use reverse side if necessary)

Show info such as: History of corner, with reference to Vol. and pg., dates, surveyor; exact description of monument replaced; if location computed, by taped or EDM traverse; landowner, remarks, etc.

SEAL:

CORNER USED BY JOHN ORTH IN 1979 & RICHARD OSBORN ON UNDATED SURVEY TIE SHEET FILED FOR THIS CORNER IN 1985; CORNER WAS NOT FOUND; I RESET THE CORNER BASED ON BOWDREN SURVEY & TIES TO IT.

CERTIFIED CORRECT

Nancy R. Rust
 Registered Land Surveyor

DATE: 4/12/95

TIE SKETCH

Show at least three (3) ties and monuments

