


Survey Monument Record

CORNER NO. 14
SECTION 6
TOWN 3N
RANGE 1E

TYPE OF MONUMENT 7/8" x 24" IRON BAR
SET WITH LAFAYETTE COUNTY CAP.

FIELD BOOK: 94-23
PAGE _____

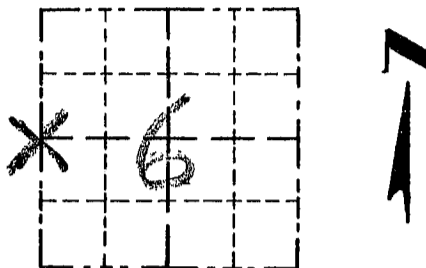


LOCATION
(Indicated by "X")

BASIS FOR MONUMENT LOCATION

(Use reverse side if necessary)

Show info such as: History of corner, with reference to Vol. and pg., dates, surveyor; exact description of monument replaced; if location computed, by taped or EDM traverse; landowner, remarks, etc.

SEAL:

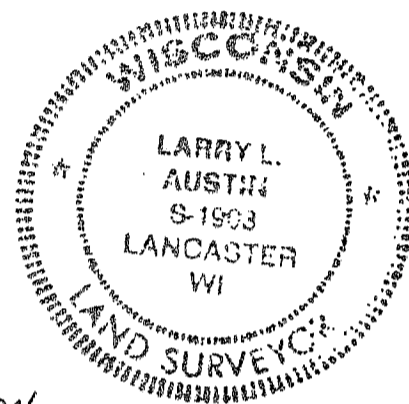

CORNER SET IN 1832 BY LUCIUS LYON. NO RECORD OF CORNER FOUND SINCE ORIGINAL SURVEY; CORNER SET IN A FENCE NORTH / SOUTH FOR EASTING; CORNER SET MIDWAY BETWEEN NORTHWEST AND SOUTHWEST CORNERS OF SECTION. VERIFIED ITS LOCATION USING EDM METHODS.

CERTIFIED CORRECT

Larry L. Austin
Registered Land Surveyor

DATE: 5/30/97

TIE SKETCH

Show at least three (3) ties and monument

LEGEND

- ⊕ 7/8" x 24" IRON BAR SET WITH LAFAYETTE COUNTY CAP
- 1/2" x 15" IRON BAR SET

XX EXISTING FENCE

FIELDS

FIELDS

