

# GRANT COUNTY CERTIFIED LAND CORNER

CORNER NUMBER 35

**CERTIFICATE:**


I, Larry L. Austin, do hereby certify that on the 14th day of November, 2000, I found evidence of the East 1/4 corner of Section 7, Town 3 North, Range 1 West, of the 4th Principal Meridian, and I re-established said corner according to the Wisconsin statutes as shown and described hereon.

Dated this 12th day of December, 2000

*Larry L. Austin*  
Larry L. Austin S-1903



SEAL

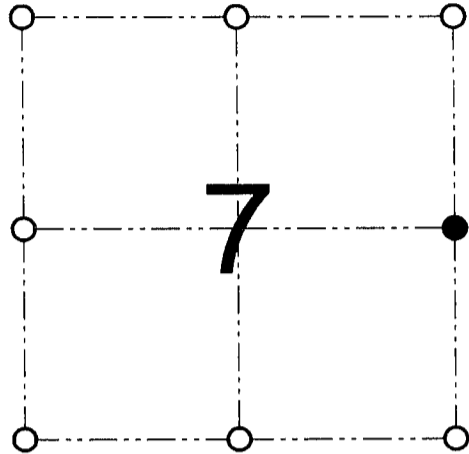

● = CORNER LOCATION

EAST 1/4 CORNER OF  
SECTION 7, T 3 N R 1 W  
TOWN OF PLATTEVILLE

**HISTORY OF ORIGINAL CORNER ESTABLISHMENT:**

Corner was originally set in 1833 by Robert Clark. In 1840 Freeman tied to the corner and found a rock. In 1856 Overton tied to the corner. In 1875 Barber tied to the corner.


**DESCRIPTION OF CORNER EVIDENCE FOUND:**

I found no evidence to the location of the rock. I reset the corner proportionately along the East line of Section 7. Verified this location using EDM & GPS methods.

**DESCRIPTION OF CORNER AND WITNESS MONUMENTS, references and accessories used to perpetuate the original or re-established location of this corner**

WITNESS TO THE CORNER LOCATION: SHANE AUSTIN & TIM FAUVER & BOBBY SEDGWICK

**SKETCH:**

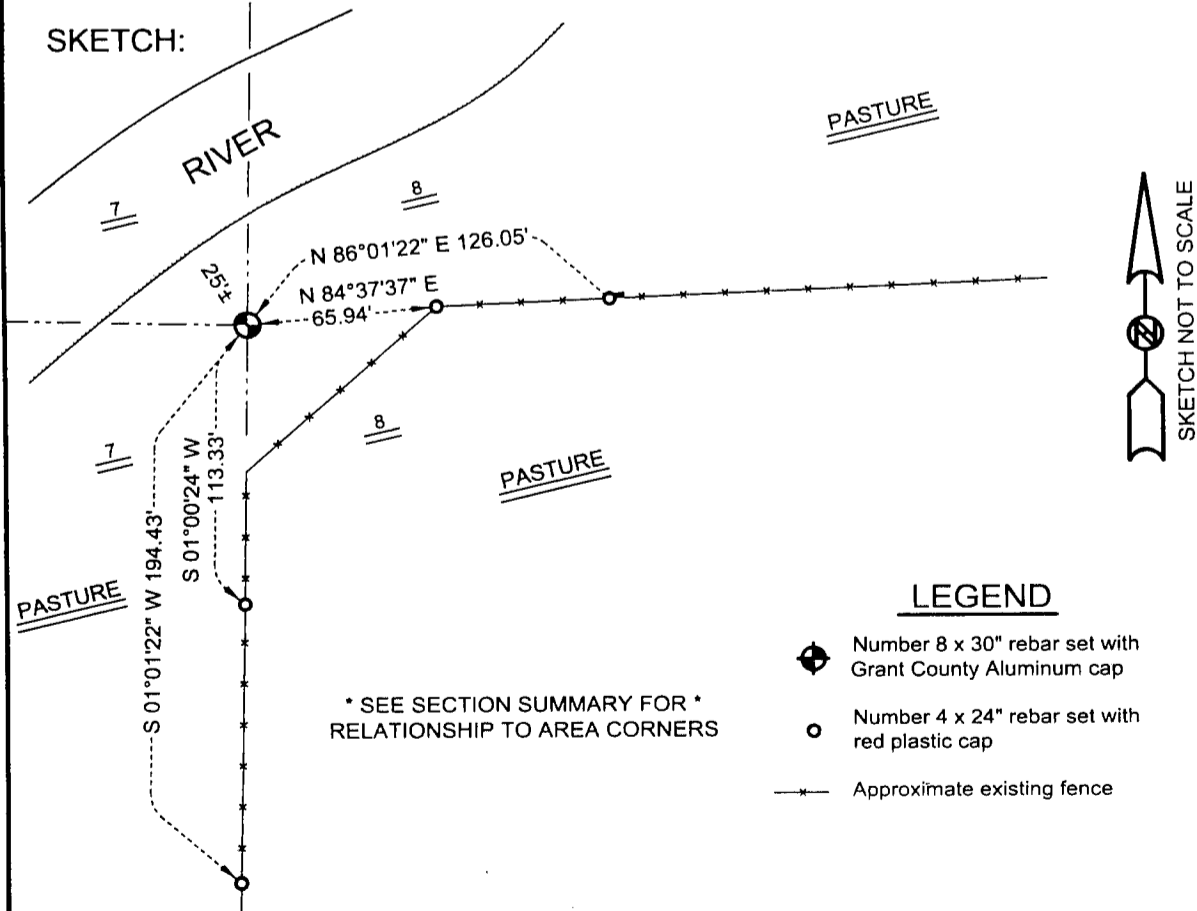

**LEGEND**

- Number 8 x 30" rebar set with Grant County Aluminum cap
- Number 4 x 24" rebar set with red plastic cap
- Approximate existing fence

**AUSTIN ENGINEERING, LLC**  
4211 HWY 81 E, LANCASTER, WI 53813  
PHONE 608-723-6363 FAX 608-723-6702

FIELDBOOK: SDR33, 2001  
G:\T3NR1W\18  
C:\SC14\SWA\TIE\T3NR1W\35

DRAWN BY: SW AUSTIN  
APPROVED: LL AUSTIN  
CREW: BS - SB - SA - TF

JUN 14 2001