

U.S. PUBLIC LAND SURVEY MONUMENT RECORD - GRANT COUNTY, WI

Section 9, Town 3 North Range 1 West, Town of Platteville (a)

NOTE: This form is intended and designed to fulfill all requirements of the Wisconsin Administrative Code Chapter A-E 7.08, U.S. Public Land Survey Monument Record (3) (a) (b) (c) (d) (e) (f) (g) (h) (i).


CERTIFICATE: (i)

I, Aaron J. Austin, Wisconsin Professional Land Surveyor, do hereby certify that the corner location on this record was determined by me and/or under my direct supervision and that this U.S. Public Land Survey Monument Record is correct and complete to the best of my knowledge and belief.

Grant County I.D. No. 36.5

Dated this 22nd day of May, 2018.

Aaron J. Austin
Aaron J. Austin, S-2922

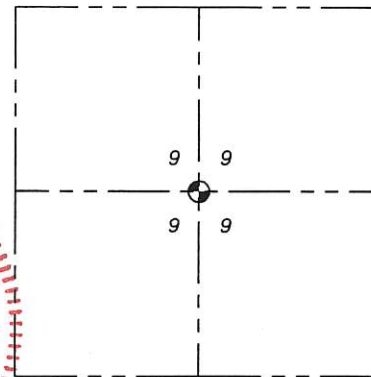

☉ = CORNER LOCATION

HISTORY OF CORNER ESTABLISHMENT:

Corner was not set with original survey.
Stuntz established the corner in 1845 on a Survey filed in Book A, Page 289.
Stuntz tied to the corner in 1845 on a Survey filed in Book A, Page 301.
McFall set a Stone at the corner in 1874 on a Survey filed in Book C, Page 269.

DESCRIPTION OF CORNER EVIDENCE FOUND: (b) (f) (g) (h)

I found the Stone as referenced on the Survey filed in Book C, Page 269 at an existing fence corner. I set four witness corners after I verified the monuments location with G.P.S. and E.D.M methods.

DESCRIPTION OF CORNER AND WITNESS MONUMENTS, references and accessories used to perpetuate the original or re-established location of this corner. (c) (d) (e)

Witnesses to corner location Shane Austin.

SKETCH:

LEGEND

- ☉ Section Corner—as designated
- 3/4" x 18" rebar set
- x-x- Existing fence

