

# GRANT COUNTY CERTIFIED LAND CORNER


CORNER NO. 3

**CERTIFICATE:**

I, LARRY L. AUSTIN, DO HEREBY CERTIFY THAT ON FIRST DAY OF MAY, 1999, I FOUND OCCUPATIONAL EVIDENCE OF THE CENTER OF SECTION 13, TOWN 3 NORTH, RANGE 1 WEST, OF THE FOURTH PRINCIPAL MERIDIAN, AND I RE-ESTABLISHED SAID CORNER ACCORDING TO THE WISCONSIN STATUTES AS SHOWN AND DESCRIBED HEREON.

DATED THIS TWENTY-SECOND DAY OF MAY, 1999

*Larry L. Austin*  
LARRY L. AUSTIN S-1903

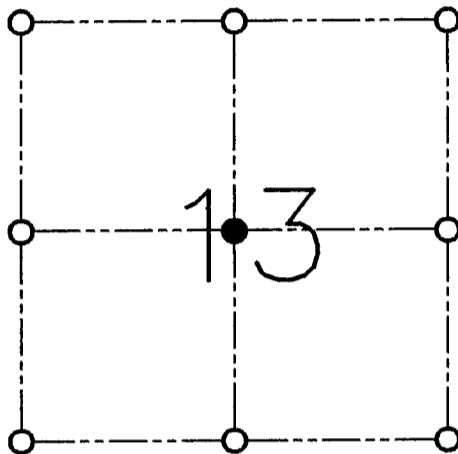

● = CORNER LOCATION

**CENTER OF SECTION 13  
T 3 N R 1 W  
TOWN OF PLATTEVILLE**

**HISTORY OF ORIGINAL CORNER ESTABLISHMENT:**

CORNER WAS NOT ORIGINALLY SET.

**DESCRIPTION OF CORNER EVIDENCE FOUND:**

I SET THE CORNER AT THE INTERSECTION OF THE 1/4 LINES. VERIFIED THIS LOCATION USING E.D.M. AND G.P.S. METHODS.

**DESCRIPTION OF CORNER AND WITNESS MONUMENTS, REFERENCES AND ACCESSORIES USED TO PERPETUATE THE ORIGINAL OR RE-ESTABLISHED LOCATION OF THIS CORNER:**

**WITNESS TO THE CORNER LOCATION:**

BOBBY SEDGWICK  
SHELBY BLINDERT

**SKETCH:**

