

GRANT COUNTY CERTIFIED LAND CORNER


CERTIFICATE:

I, LARRY L. AUSTIN, DO HEREBY CERTIFY THAT ON THIRTIETH DAY OF APRIL, 1999, I FOUND MONUMENTED EVIDENCE OF THE WEST 1/4 CORNER SECTION 30, TOWN 3 NORTH, RANGE 1 WEST, OF THE FOURTH PRINCIPAL MERIDIAN, AND I RE-ESTABLISHED SAID CORNER ACCORDING TO THE WISCONSIN STATUTES AS SHOWN AND DESCRIBED HEREON.

CORNER NUMBER 94

DATED THIS TWENTY-SECOND DAY OF MAY, 1999

Larry L. Austin
LARRY L. AUSTIN S-1903

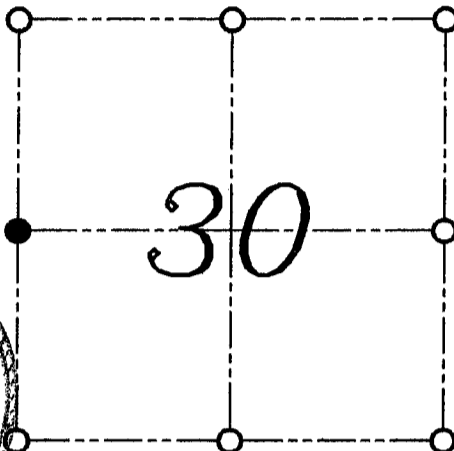

● = CORNER LOCATION
WEST 1/4 CORNER OF
SECTION 30, T 3 N R 1 W
TOWN OF PLATTEVILLE

SEAL

HISTORY OF ORIGINAL CORNER ESTABLISHMENT:

CORNER WAS NEVER ORIGINALLY SET. I SET THE CORNER IN 1992 AT THE PROPORTIONED OFFSET ON THE EAST LINE OF THE NORTHEAST 1/4 OF SECTION 25, T3N R2W.

DESCRIPTION OF CORNER EVIDENCE FOUND:

I FOUND THE EXISTING 1" IRON PIPE AND ACCEPTED THIS LOCATION AFTER AN E.D.M. TRAVERSE OF THE AREA.

**DESCRIPTION OF CORNER AND WITNESS MONUMENTS, REFERENCES AND ACCESSORIES USED TO PERPETUATE THE ORIGINAL OR RE-ESTABLISHED LOCATION OF THIS CORNER:
WITNESS TO THE CORNER LOCATION: BOBBY SEDGWICK ; SHELBY BLINDERT**

SKETCH:

