

# GRANT COUNTY CERTIFIED LAND CORNER

CORNER NUMBER 95

**CERTIFICATE:**


I, LARRY L. AUSTIN, DO HEREBY CERTIFY THAT ON TWELFTH DAY OF MAY, 1999, I FOUND MONUMENTED EVIDENCE OF THE WEST 1/4 CORNER SECTION 29, TOWN 3 NORTH, RANGE 1 WEST, OF THE FOURTH PRINCIPAL MERIDIAN, AND I RE-ESTABLISHED SAID CORNER ACCORDING TO THE WISCONSIN STATUTES AS SHOWN AND DESCRIBED HEREON.

DATED THIS TWENTY-SECOND DAY OF MAY, 1999

*Larry L. Austin*  
LARRY L. AUSTIN S-1903



SEAL

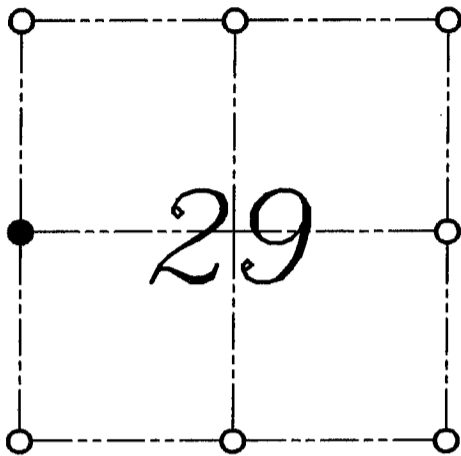

● = CORNER LOCATION  
WEST 1/4 CORNER OF  
SECTION 29, T 3 N R 1 W  
TOWN OF PLATTEVILLE

**HISTORY OF ORIGINAL CORNER ESTABLISHMENT:**

CORNER WAS SET IN 1833 BY ROBERT CLARK.

**DESCRIPTION OF CORNER EVIDENCE FOUND:**

I FOUND AN EXISTING 3/4" IRON BAR AT AN OCCUPIED FENCE CORNER. I ACCEPTED THIS LOCATION AFTER AND E.D.M. AND G.P.S. TRAVERSE OF THE AREA.

**DESCRIPTION OF CORNER AND WITNESS MONUMENTS, REFERENCES AND ACCESSORIES USED TO PERPETUATE THE ORIGINAL OR RE-ESTABLISHED LOCATION OF THIS CORNER:**  
WITNESS TO THE CORNER LOCATION: BOBBY SEDGWICK ; SHELBY BLINDERT

**SKETCH:**

**LEGEND**

- 3/4" IRON BAR FOUND AND SET A GRANT COUNTY ALUMINUM CAP ON TOP
- NUMBER 4 X 24" REBAR SET WITH RED PLASTIC CAP AND SIGN
- ⚡ "D.O.T. SURVEY MARKER NEARBY" SIGN SET
- \*\*\* EXISTING FENCE LOCATION

