


Survey Monument Record

TYPE OF MONUMENT 1" IRON PIPE
FOUND

CORNER NO. 111
SECTION 31
TOWN 3N
RANGE 1W

FIELD BOOK: 97-33
PAGE _____

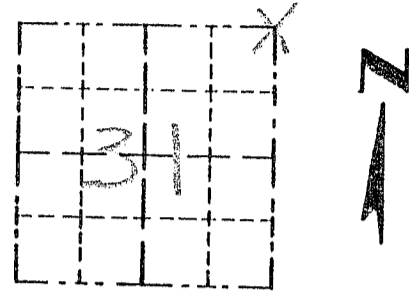

LOCATION
(Indicated by "X")

BASIS FOR MONUMENT LOCATION

(Use reverse side if necessary)

Show info such as: History of corner, with reference to Vol. and pg., dates, surveyor; exact description of monument replaced; if location computed, by taped or EDM traverse; landowner, remarks, etc.

SEAL:



CORNER SET IN 1833 BY ROBERT CLARK. NO RECORD OF CORNER FOUND SINCE ORIGINAL SURVEY; 1" IRON PIPE WAS FOUND AT AN OCCUPIED LOCATION. VERIFIED ITS LOCATION USING EDM METHODS.

CERTIFIED CORRECT

Larry L. Austin
Registered Land Surveyor

DATE: 12/5/97

TIE SKETCH

Show at least three (3) ties and monument

LEGEND

- ⊕ 1" IRON PIPE FND.
- 1/2" x 15" IRON BAR SET
- XX EXISTING FENCE

