

U.S. PUBLIC LAND SURVEY MONUMENT RECORD - GRANT COUNTY, WI

Section 19, Town 3 North Range 4 West, Town of Waterloo (a)

NOTE: This form is intended and designed to fulfill all requirements of the Wisconsin Administrative Code Chapter A-E 7.08, U.S. Public Land Survey Monument Record (3) (a) (b) (c) (d) (e) (f) (g) (h) (i).

CERTIFICATE: (i)

I, Aaron J. Austin, Wisconsin Professional Land Surveyor, do hereby certify that the corner location on this record was determined by me and/or under my direct supervision and that this U.S. Public Land Survey Monument Record is correct and complete to the best of my knowledge and belief.

Dated this 23rd day of October, 2023.

Aaron J. Austin
Aaron J. Austin, S-2922

Grant County Coordinates:
NAD 83 (2011)
Northing: 476,721.15
Easting: 768,374.92



⊕ = CORNER LOCATION

HISTORY OF CORNER ESTABLISHMENT:

Corner was not set with the Original Government Survey.

Larry Austin set a 1" Rebar with a Grant County Aluminum Cap and prepared a Survey Monument Record dated 7-28-2000.

DESCRIPTION OF CORNER EVIDENCE FOUND: (b) (f) (g) (h)

I found the Aluminum Capped Rebar and two witness corners Larry set. I established two witness corners after I verified the Monument's location with G.P.S. and E.D.M. methods.


DESCRIPTION OF CORNER AND WITNESS MONUMENTS:

references and accessories used to perpetuate the original or re-established location of this corner. (c) (d) (e)

Witnesses to corner location Owen Austin, Tanner Austin.

Drawn by: Owen Austin.

SKETCH:

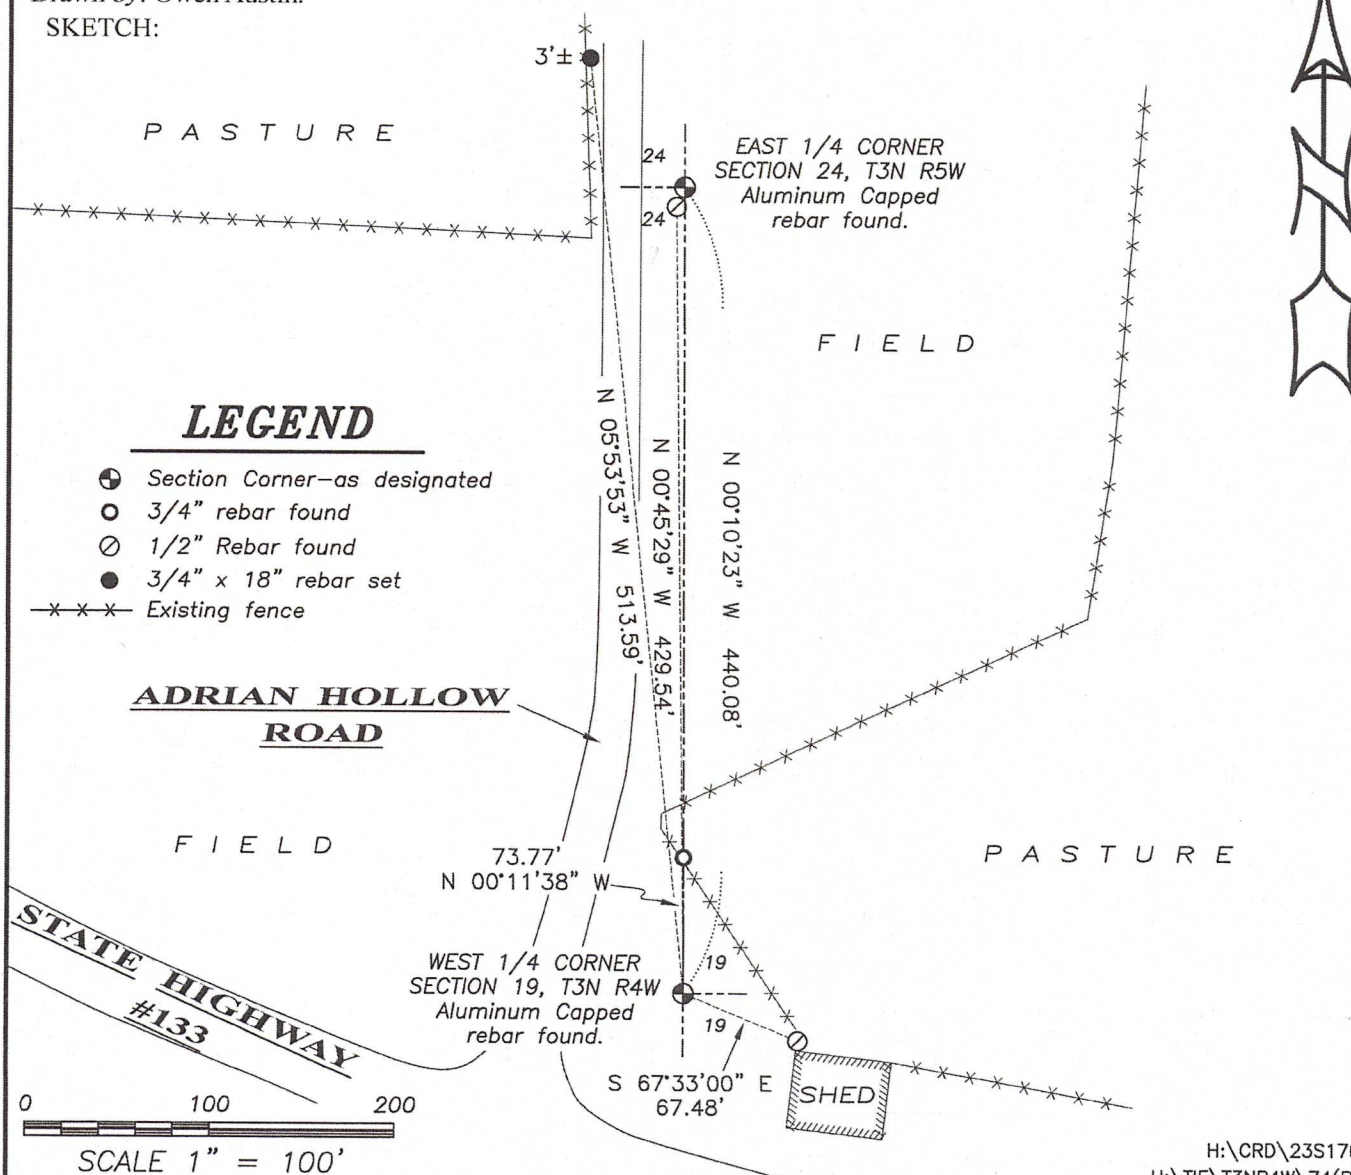

GRANT COUNTY
CERTIFIED LAND CORNER


CORNER NUMBER 74

CERTIFICATE:

I, Larry L. Austin, do hereby certify that on the 12th day of September, 2000, I found evidence of the West 1/4 corner of Section 19, Town 3 North, Range 1 West, of the 4th Principal Meridian, and I re-established said corner according to the Wisconsin statutes as shown and described hereon.

Dated this 8th day of November, 2000

Larry L. Austin
Larry L. Austin S-1903

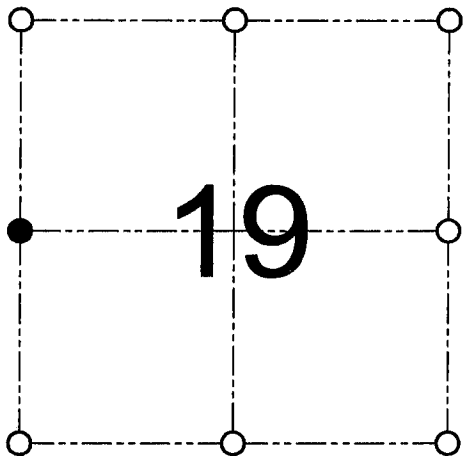

● = CORNER LOCATION

WEST 1/4 CORNER OF
SECTION 19, T 3 N R 1 W
TOWN OF PLATTEVILLE

HISTORY OF ORIGINAL CORNER ESTABLISHMENT:

Corner was never originally set. In 1851 Everett tied to the corner. In 1993 I set an aluminum monument.

DESCRIPTION OF CORNER EVIDENCE FOUND:

I found the Aluminum monument and accepted it's location after an EDM & GPS traverse of the area.

DESCRIPTION OF CORNER AND WITNESS MONUMENTS, references and accessories used to perpetuate the original or re-established location of this corner

WITNESS TO THE CORNER LOCATION: SHANE AUSTIN & JASON MILES & BOBBY SEDGWICK

SKETCH:

