


# SECTION SUMMARY

SECTION 30 TOWN 3N RANGE 1E

25-3-1W

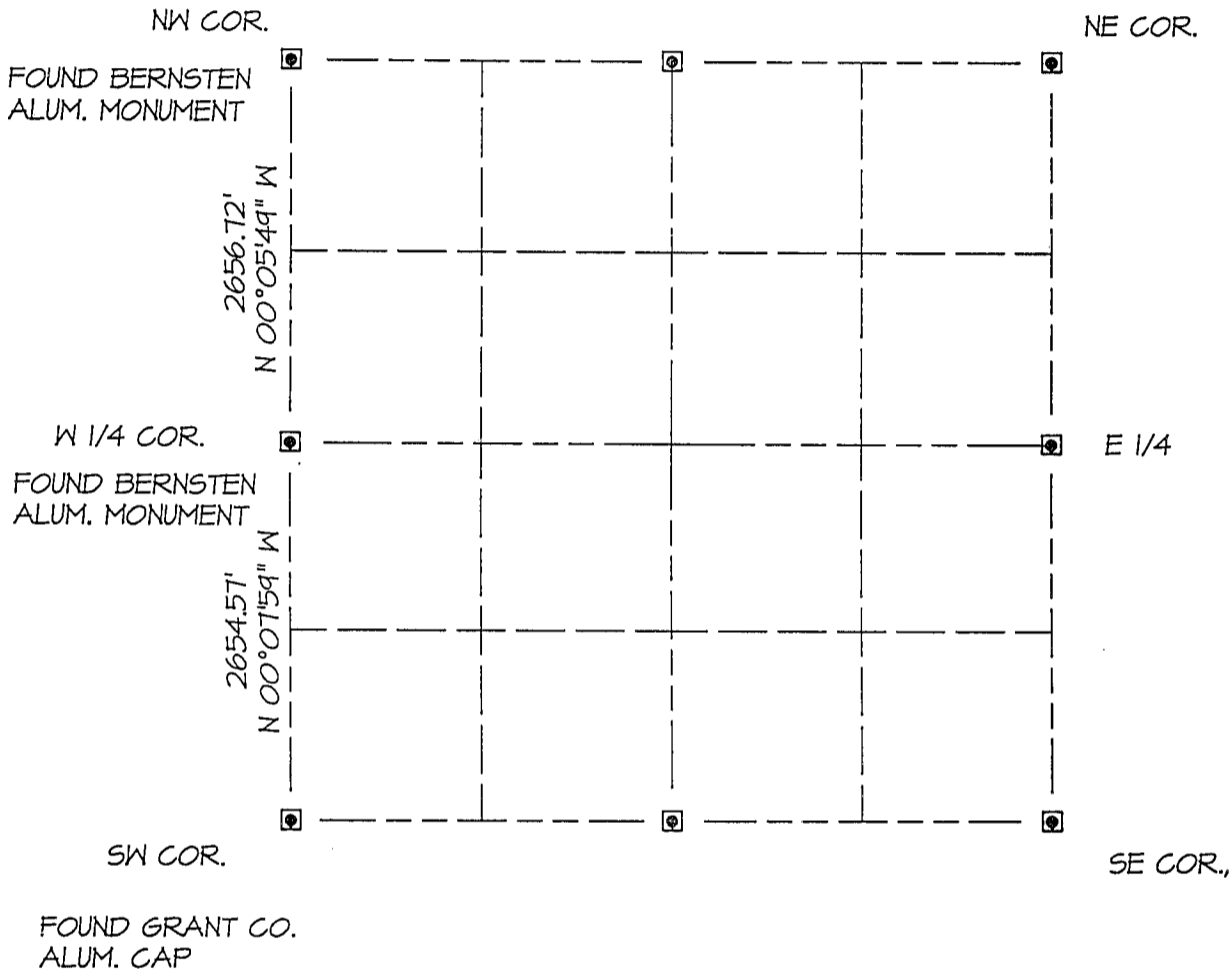

**LEGEND:**

- ◻ SECTION CORNER AS DESCRIBED
- ◻ STONE MONUMENT FOUND
- IRON PIPE FOUND - INDICATE DIAMETER
- REBAR FOUND - INDICATE DIAMETER
- OTHER - DESCRIBE FULLY

**BEARING REFERENCE -**


PLAT BEARINGS ARE ORIENTED TOWARD THE LAFAYETTE COUNTY COORDINATE SYSTEM AS DEFINED BY THE WISCONSIN DEPARTMENT OF TRANSPORTATION, THE WEST LINE OF SW 1/4 OF SECTION 30, T3N, R1E, OF WHICH COMPUTES TO BEAR N 00°07'59" W

JOB ID: 2007-6

COUNTY COORDINATE INDICATE CORNER SW 30-3-1E

NORTHING 172345.82

EASTING 400184.17

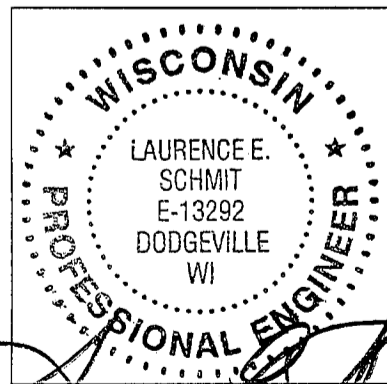

*Laurence E. Schmit*  
5-8-07