

GRANT COUNTY CERTIFIED LAND CORNER


CORNER NUMBER 40

CERTIFICATE:

I, Larry L. Austin, do hereby certify that on the 16th day of March, 2000, I found no evidence of the East 1/4 corner of Section 12, Town 3 North, Range 2 West, of the 4th Principal Meridian, and I re-established said corner according to the Wisconsin statutes as shown and described hereon.

Dated this 16th day of April, 2000

Larry L. Austin
Larry L. Austin S-1903

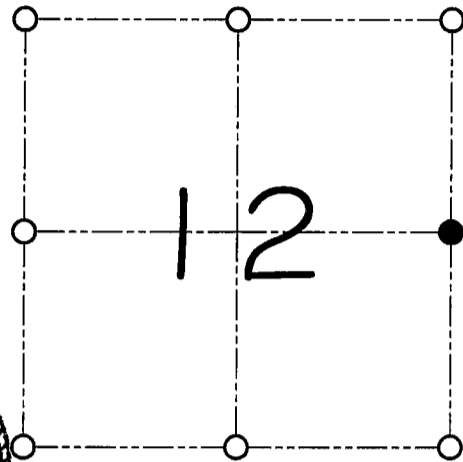

● = CORNER LOCATION

EAST 1/4 CORNER OF SECTION 12, T 3 N R 2 W TOWN OF HARRISON

HISTORY OF ORIGINAL CORNER ESTABLISHMENT:

Corner was originally set in 1832 by Lucuis Lyon.
No other record of the corner was found.

DESCRIPTION OF CORNER EVIDENCE FOUND:

I reset the corner at the proportioned offset from the occupied West 1/4 of Section 7. Verified this location using E.D.M. & G.P.S. methods.


DESCRIPTION OF CORNER AND WITNESS MONUMENTS, references and accessories used to perpetuate the original or re-established location of this corner

WITNESS TO THE CORNER LOCATION: BOBBY SEDGWICK & SHELBY BLINDERT

SKETCH:

LEGEND

- Number 8 by 30" rebar set with Grant County aluminum cap
- Number 4 by 24" rebar set with red plastic cap
- ×× Existing fence location

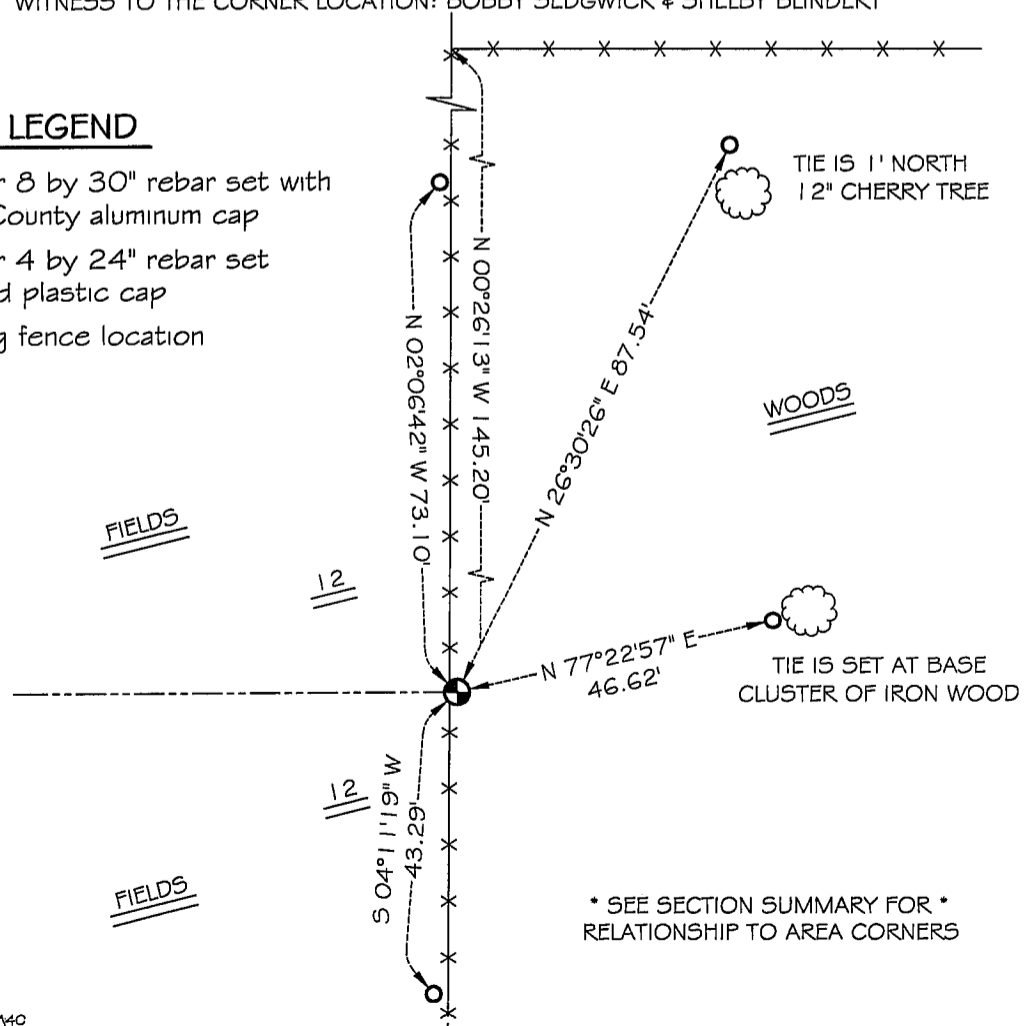

* SEE SECTION SUMMARY FOR *
RELATIONSHIP TO AREA CORNERS