

GRANT COUNTY CERTIFIED LAND CORNER

CORNER NUMBER 83

CERTIFICATE:

I, Larry L. Austin, do hereby certify that on the 20th day of July, 2000, I found evidence of the Southwest corner of Section 24, Town 3 North, Range 2 West, of the 4th Principal Meridian, and I re-established said corner according to the Wisconsin statutes as shown and described hereon.

Dated this 8th day of November, 2000

Larry L. Austin
Larry L. Austin S-1903


Grant County Cook.

N 473805.2

E 858535.9



SEAL

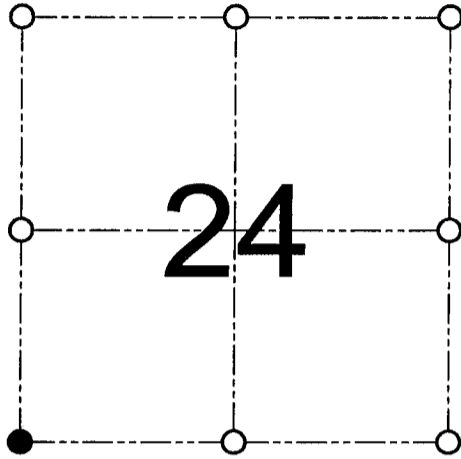

● = CORNER LOCATION

SOUTHWEST CORNER OF
SECTION 24, T'3 N R 2 W
TOWN OF HARRISON

HISTORY OF ORIGINAL CORNER ESTABLISHMENT:

Corner was originally set in 1833 by Clark.
In 1873 McFall tied to the corner.

DESCRIPTION OF CORNER EVIDENCE FOUND:

I found an existing Number 6 iron bar at an occupied fence corner.
I accepted it's location after an EDM & GPS traverse of the area.

DESCRIPTION OF CORNER AND WITNESS MONUMENTS, references and accessories used to perpetuate the original or re-established location of this corner

WITNESS TO THE CORNER LOCATION: SHANE AUSTIN & SHELBY BLINDERT & BOBBY SEDGWICK

SKETCH:

