

# U.S. PUBLIC LAND SURVEY MONUMENT RECORD - GRANT COUNTY, WI

Section 34, Town 3 North Range 2 West, Town of Harrison (a)

NOTE: This form is intended and designed to fulfill all requirements of the Wisconsin Administrative Code Chapter A-E 7.08, U.S. Public Land Survey Monument Record (3) (a) (b) (c) (d) (e) (f) (g) (h) (i).


**CERTIFICATE: (i)**

I, Aaron J. Austin, Wisconsin Professional Land Surveyor, do hereby certify that the corner location on this record was determined by me and/or under my direct supervision and that this U.S. Public Land Survey Monument Record is correct and complete to the best of my knowledge and belief.

Dated this 3rd day of March, 2026.

*Aaron J. Austin*

Aaron J. Austin, PLS-2922

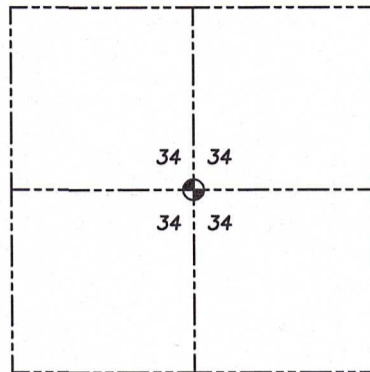

⊕ = CORNER LOCATION

**Grant County Coordinates:**

NAD 83 (2011)

Northing: 465,851.55

Easting: 850,630.98

**HISTORY OF CORNER ESTABLISHMENT:**

Corner was not set with the Original Government Survey. Geo Stuntz established the Corner on a Survey filed in Book B, Page 112 dated 3-9-1848. I set 3/4" Rebar on a Plat of Survey Filed in Book 44, Page 18 dated 10-4-2019.

**DESCRIPTION OF CORNER EVIDENCE FOUND: (b) (f) (g) (h)**

I found the 3/4" Rebar I set in 2019. I set four witness corner and verified the Monument's location with G.P.S. methods.

**DESCRIPTION OF CORNER AND WITNESS MONUMENTS,** references and accessories used to perpetuate the original or re-established location of this corner. (c) (d) (e)

Witnesses to corner location Owen Austin, Tanner Austin.

Drawn by: Owen Austin.

**SKETCH:**

## LEGEND

- ⊕ Section Corner—as designated
- 3/4" x 18" rebar set
- ⊕ Existing utility pole
- x-x-x Existing fence
- ⊕ Existing stop sign

