


U.S. PUBLIC LAND SURVEY MONUMENT RECORD – GRANT COUNTY, WI

Summary of Section 25, Town 3 North, Range 2 West, Town of Harrison



25

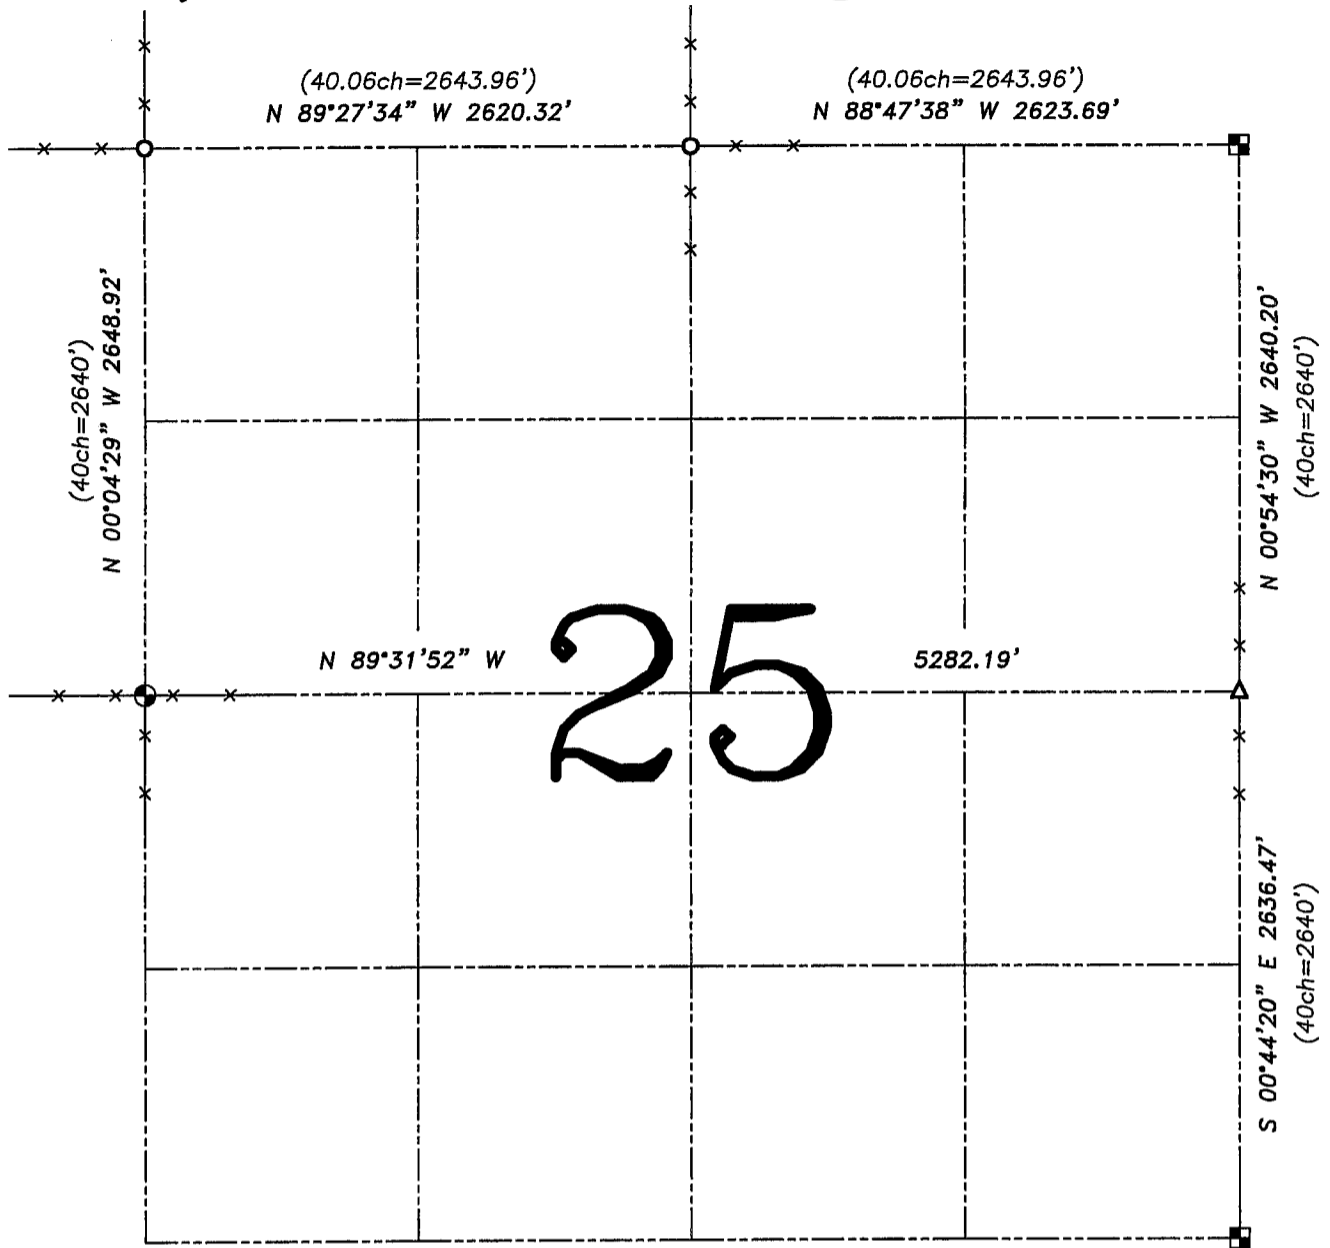

LEGEND

- No. 8 x 30" rebar set with Grant County Aluminum Cap – wt=2.67#/l.f.
- No. 6 rebar found
- No. 10 rebar found
- Aluminum Monument found
- ▲ 1" diameter iron pipe found
- () Recorded as
- x— Approximate location of existing fence

Relationship of all section corners to other section corners shall be shown hereon by bearing and distance or grid coordinates. Bearing reference shown below.

Dated this 3 day of MAY 2006

Larry L. Austin
Larry L. Austin S-1903

Bearings referenced to the North line of the NW 1/4 of this Section, which is assumed to bear N 89°27'34" W.

SKETCH NOT TO SCALE



Austin Engineering LLC

4211 HWY 81 E, LANCASTER, WI 53813
PHONE 608-723-6363 FAX 608-723-6702

JOB NUMBER: 05S123
FIELDBOOK: TDSR, 2514
G:\T3NR2W\24
H:\TIE\T3NR2W\25SUM

DRAWN BY: SW AUSTIN
APPROVED: LL AUSTIN