


# U.S. PUBLIC LAND SURVEY MONUMENT RECORD – GRANT COUNTY, WI

Summary of Section 33, Town 3 North, Range 2 West, Town of Harrison

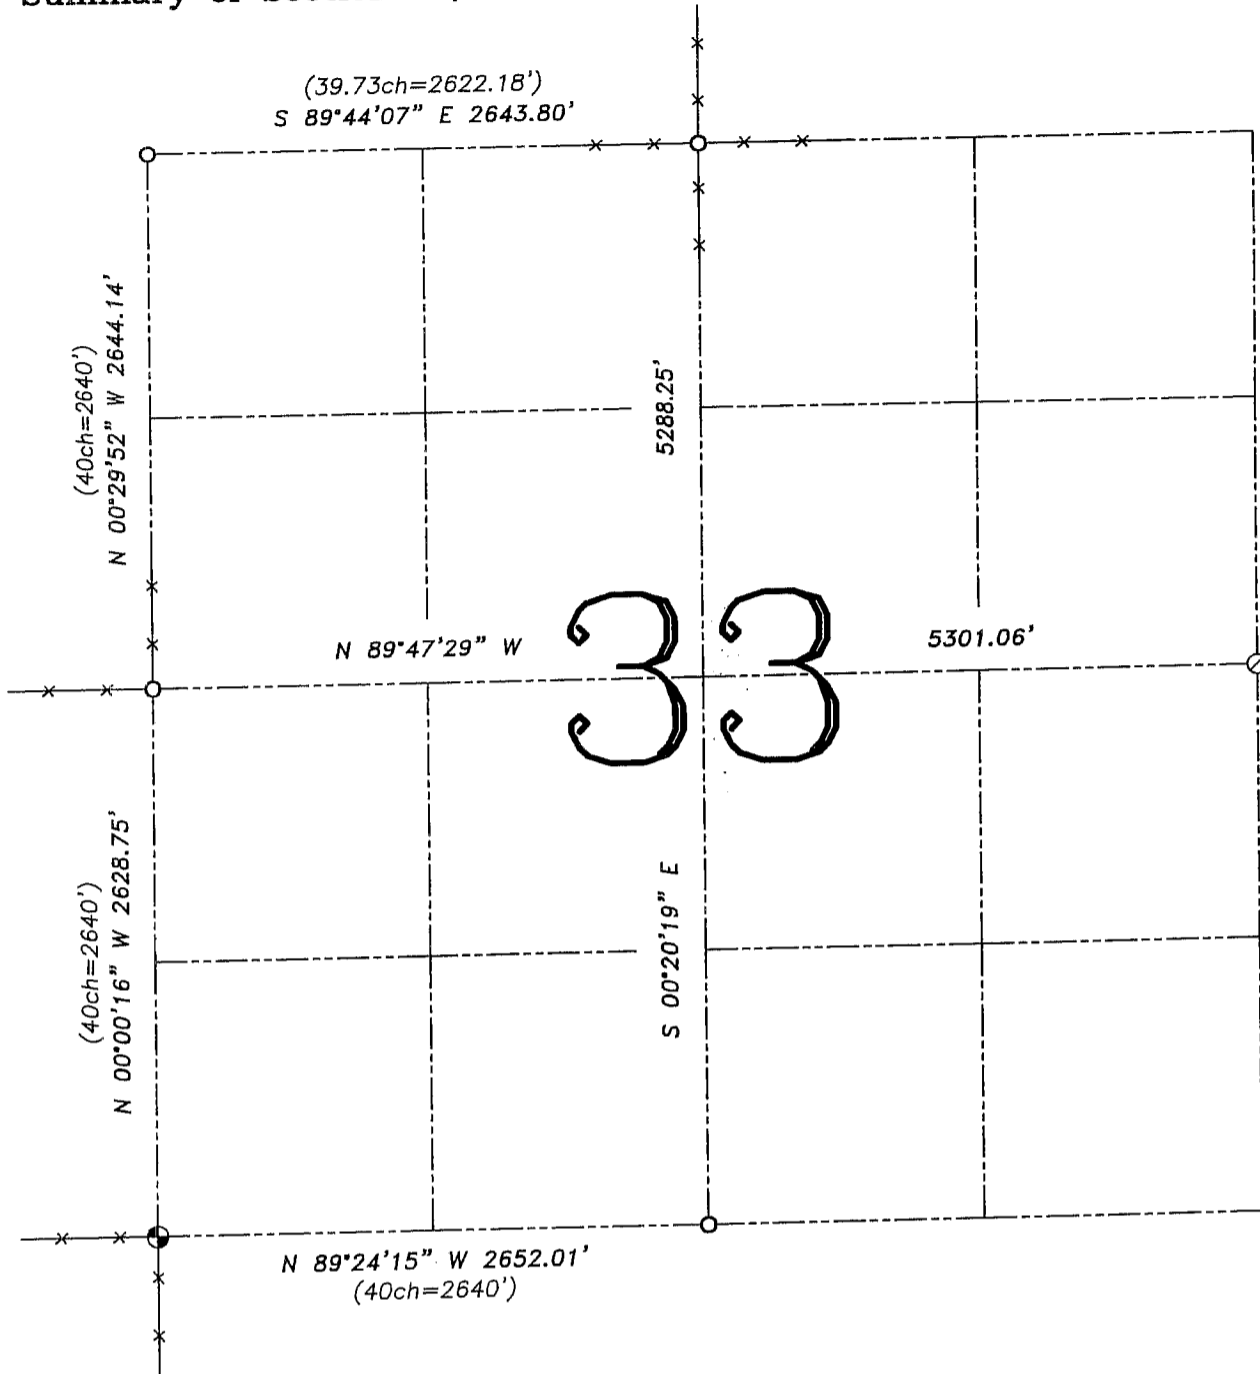

## LEGEND

- ⊙ No. 8 x 30" rebar set with Grant County Aluminum Cap – wt=2.67#/l.f.
- No. 6 rebar found
- ⊙ PK Nail found
- ( ) Recorded as
- x— Approximate location of existing fence

Relationship of all section corners to other section corners shall be shown hereon by bearing and distance or grid coordinates. Bearing reference shown below.

Dated this 22nd day of December, 2005

*Larry L. Austin*  
Larry L. Austin S-1903

Bearings referenced to the South line of the SW 1/4 of this Section, which is assumed to bear N  $89^{\circ}24'15''$  W.

SKETCH NOT TO SCALE



**Austin Engineering LLC**

4211 HWY 81 E, LANCASTER, WI 53813  
PHONE 608-723-6363 FAX 608-723-6702

JOB NUMBER: 05S313  
FIELDBOOK: TDSR, 2508  
G:\T3NR2W\33A  
H:\TIE\T3NR2W\33SUM

DRAWN BY: SW AUSTIN  
APPROVED: LL AUSTIN