

U.S. PUBLIC LAND SURVEY MONUMENT RECORD – GRANT COUNTY, WI


Section 1, Town 3 North Range 3 West, Town of Potosi

CERTIFICATE

I, Larry L. Austin, do hereby certify that the corner location on this record was determined by me and/or under my direct supervision and that this U.S. public land survey monument record is correct and complete to the best of my knowledge and belief.

Dated this 21st day of February, 2005

Larry L. Austin
Larry L. Austin S-1903

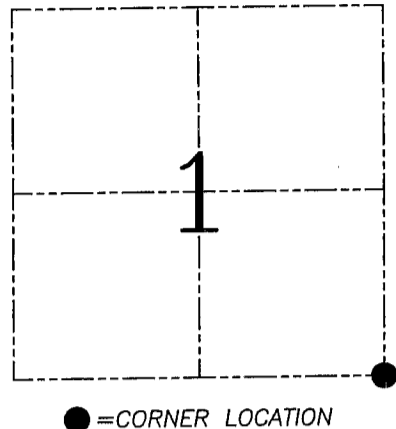

HISTORY OF CORNER ESTABLISHMENT

Corner was originally set in 1832 by Lyon. In 1858 Overton measured to the corner while working in this Section and in Section 6, T3N R2W. No other record of the corner was found.

DESCRIPTION OF CORNER EVIDENCE FOUND



I set the corner at the recorded offset from the Southwest corner of Section 6. Verified this location using EDM & GPS methods.

DESCRIPTION OF CORNER AND WITNESS MONUMENTS, references and accessories used to perpetuate the original or re-established location of this corner. Witnesses to corner location Bobby Sedgwick & Shane Austin & Brad Digman

SKETCH:

LEGEND

- ⊕ Number 8 x 30" rebar set with Grant County Aluminum cap
- Number 4 x 24" Rebar set with red plastic "TIE" cap
- x— Approximate existing fence

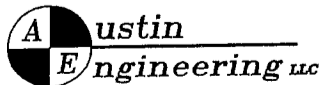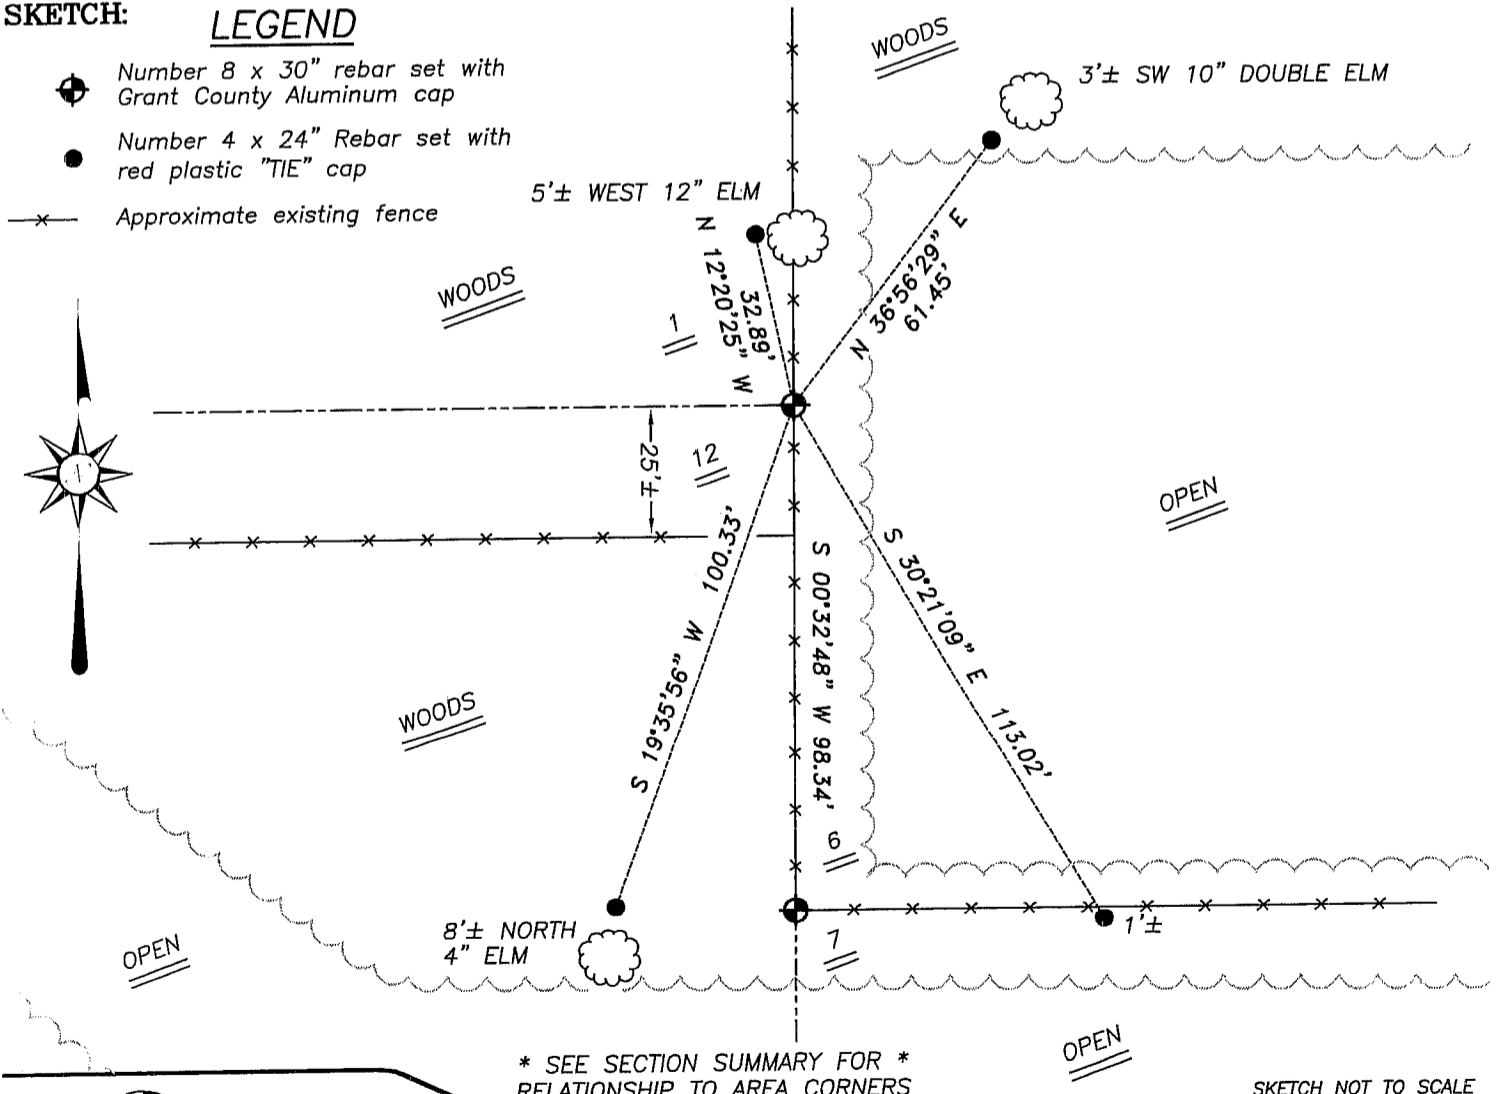

4211 HWY 81 E, LANCASTER, WI 53813
PHONE 608-723-6363 FAX 608-723-6702

JOB NUMBER 04S318
FIELDBOOK: TDSR, 2417
G:\T3NR2W\06
H:\TIE\T3NR3W\21

DRAWN BY: SW AUSTIN
APPROVED: LL AUSTIN