

Survey Monument Record

TYPE OF MONUMENT 3/4" X 24" IRON
BAR W/ CAP

CORNER NO. 24
 SECTION 02
 TOWN 30
 RANGE 3W


FIELD BOOK: 96-01
 PAGE 20

BASIS FOR MONUMENT LOCATION

(Use reverse side if necessary)


Show info such as: History of corner, with reference to Vol. and pg., dates, surveyor; exact description of monument replaced; if location computed, by taped or EDM traverse; landowner, remarks, etc.

CORNER SET IN 1833 BY
 ROBERT CLARK, NO RECORD OF
 CORNER FOUND SINCE ORIGINAL
 SURVEYS. I SET THE CORNER
 AT AN OCCUPIED LOCATION,
 VERIFIED ITS LOCATION USING
 EDM METHODS.

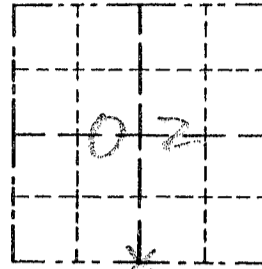

LOCATION
 (Indicated by "X")

SEAL:

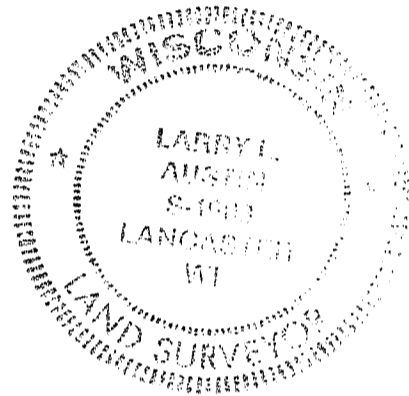

CERTIFIED CORRECT

Larry L. Auger
 Registered Land Surveyor

DATE: 12-20-97

TIE SKETCH

Show at least three (3) ties and monument

LEGEND

- ⊙ 3/4" X 24" IRON BAR SET
W/ ALUM. CAP.
- 1/2" X 15" IRON BAR SET
- XX EXISTING FENCE

