

U.S. PUBLIC LAND SURVEY MONUMENT RECORD - GRANT COUNTY, WI

Section 12, Town 3 North Range 3 West, Town of Potosi North

(a)

NOTE: This form is intended and designed to fulfill all requirements of Wisconsin Administrative Code. Chapter A-E 7.08, U.S. Public Land Survey Monument Record (3) (a) (b) (c) (d) (e) (f) (g) (h) (i). "An additional sheet *may* be added if necessary to conform with said requirements."



CERTIFICATE:

(i)

I, John Krebs, do hereby certify that the corner location on this record was determined by me and/or under my direct supervision and that this U.S. Public Land Survey Monument Record is correct and complete to the best of my knowledge and belief.

Dated this 4th day of April, 2012.

John Krebs 4-23-12
 John Krebs, S-1878

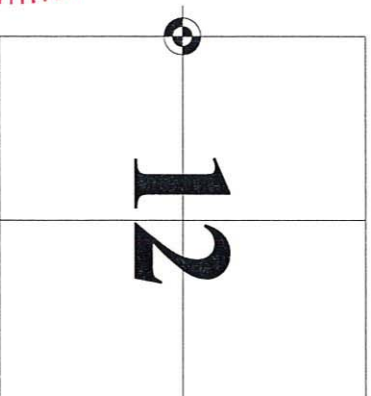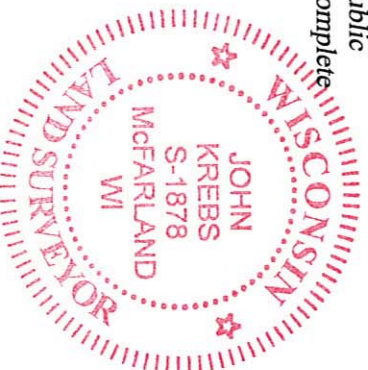

 CORNER LOCATION

HISTORY OF CORNER ESTABLISHMENT:

Original corner was set in 1833 by Robert Clark.
 Corner was reset by Larry L. Austin on September 10, 1999.
 Michael S. O'Keefe, S-2743, located corner on July 6, 2011, before road construction began.

DESCRIPTION OF CORNER EVIDENCE FOUND:

(b) (i) (g) (h)

Corner was removed during road construction. Replaced corner per location found by Michael S. O'Keefe. Found three ties per a tie sheet by Larry L. Austin, dated September 10, 1999. Set cotton pin at the Section Corner and one additional tie as shown hereon.











Witnesses to corner location _____



DESCRIPTION OF CORNER AND WITNESS MONUMENTS: references and accessories used to perpetuate the original or re-established location of this corner.

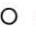(c) (d) (e)

SKETCH:

LEGEND

-  GOVERNMENT CORNER
-  3/4" REBAR FOUND
-  3/4" x 24" REBAR SET (1.50 LBS/LF)
-  MAIL BOX
-  POST
-  TELEPHONE PEDESTAL
-  SIGN
-  SECTION LINE
-  EDGE OF PAVEMENT
-  CONCRETE CURB & GUTTER

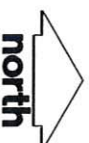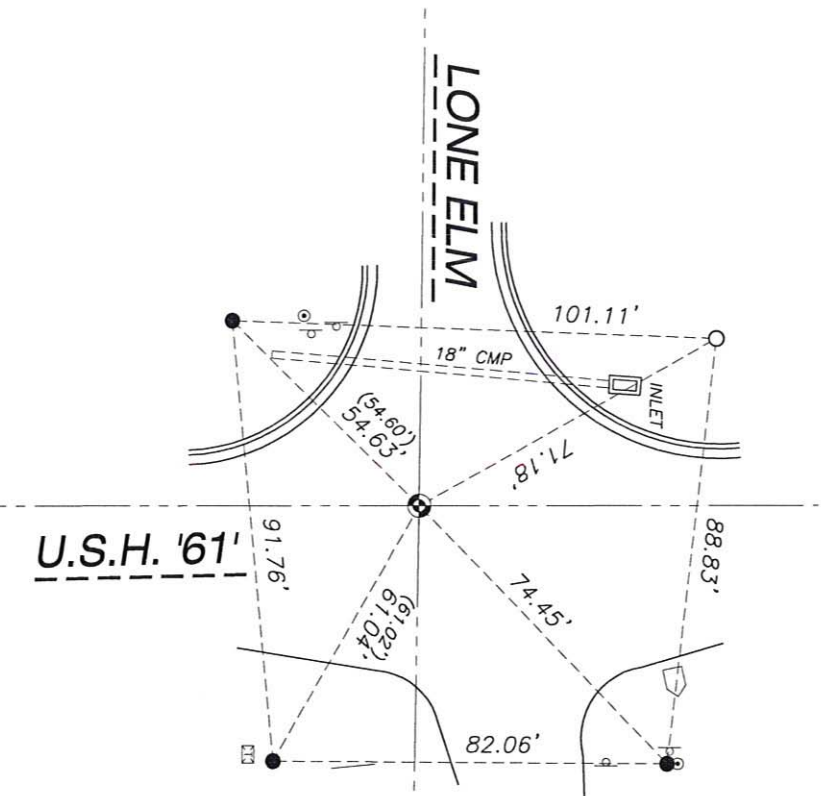

SHEET 1 OF 1


SCALE: 1" = 40'

Survey Monument Record

CORNER NO. 29
 SECTION 05
 TOWN 3N
 RANGE 3W

TYPE OF MONUMENT COUNTY MONUMENT SET
(3/4" x 24" IRON BAR W/ CAP)

FIELD BOOK: 96-01
 PAGE _____

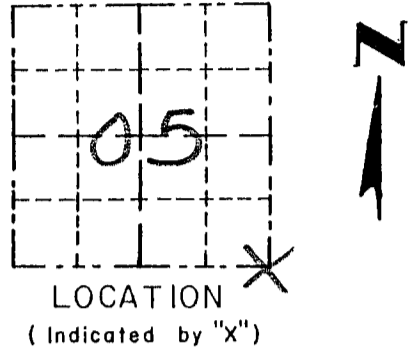


BASIS FOR MONUMENT LOCATION

(Use reverse side if necessary)

Show info such as: History of corner, with reference to Vol. and pg., dates, surveyor; exact description of monument replaced; if location computed, by taped or EDM traverse; landowner, remarks, etc.

SEAL:

ORIGINAL CORNER SET IN 1833 BY ROBERT CLARK. IN 1892 C SAMPSON LOCATED THE ORIGINAL CORNER. I ACCEPTED OCCUPATIONAL LOCATION AFTER EDM TRAVERSE OF AREA.

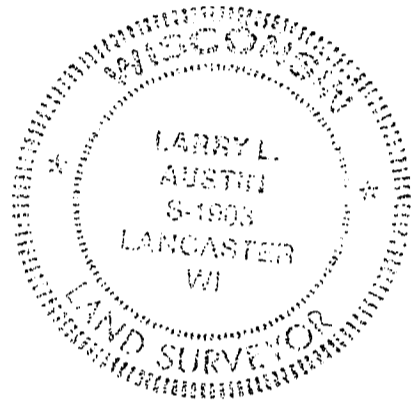

CERTIFIED CORRECT

Larry L. Austin
 Registered Land Surveyor

DATE: 2/18/98

TIE SKETCH

Show at least three (3) ties and monument

LEGEND

- ⊕ 3/4" x 24" IRON BAR W/ CAP.
- 1/2" x 15" IRON BAR SET
- XX EXISTING FENCE

