


REC'D SEP 4 1998

Survey Monument Record

TYPE OF MONUMENT 3/4" x 24" Iron Rod
STATE PLANE COORDINATES: N _____
E _____
ELEVATION — M.S.L. DATUM: _____
THETA ANGLE: _____
FIELD BOOK: _____
PAGE _____

CORNER NO. 30
SECTION 5
TOWN 3 NORTH
RANGE 3 West

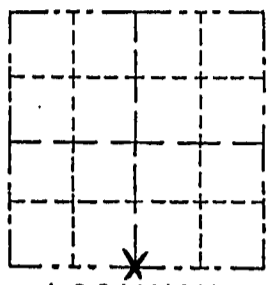


BASIS FOR MONUMENT LOCATION

(Use reverse side if necessary)
Show info such as: History of corner, with reference to Vol. and pg., dates, surveyor; exact description of monument replaced; if location computed, by taped or EDM traverse; landowner, remarks, etc.

- LOCATION
(Indicated by "X")
- FOUND PERPETUATED LOCATION
 - OBLITERATED EVIDENCE LOCATION
 - LOST CORNER (RESTORED BY PROPORTIONATE METHODS)

I PLACE THIS CORNER AT THE OCCUPIED FENCE CORNER WHICH FIT WELL WITH ALL THE OTHER CORNERS LOCATED WITHIN THE SECTION. AFTER AN E.D.M TRAVERSE OF THE AREA AND G.P.S. OBSERVATION.

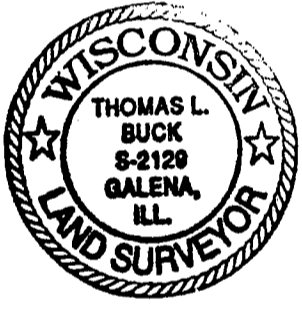


CERTIFIED CORRECT TO THE BEST OF MY KNOWLEDGE AND BELIEF

Thomas L. Buck
Registered Land Surveyor
DATE: 8/25/98

TIE SKETCH

Show at least three (3) ties and monument

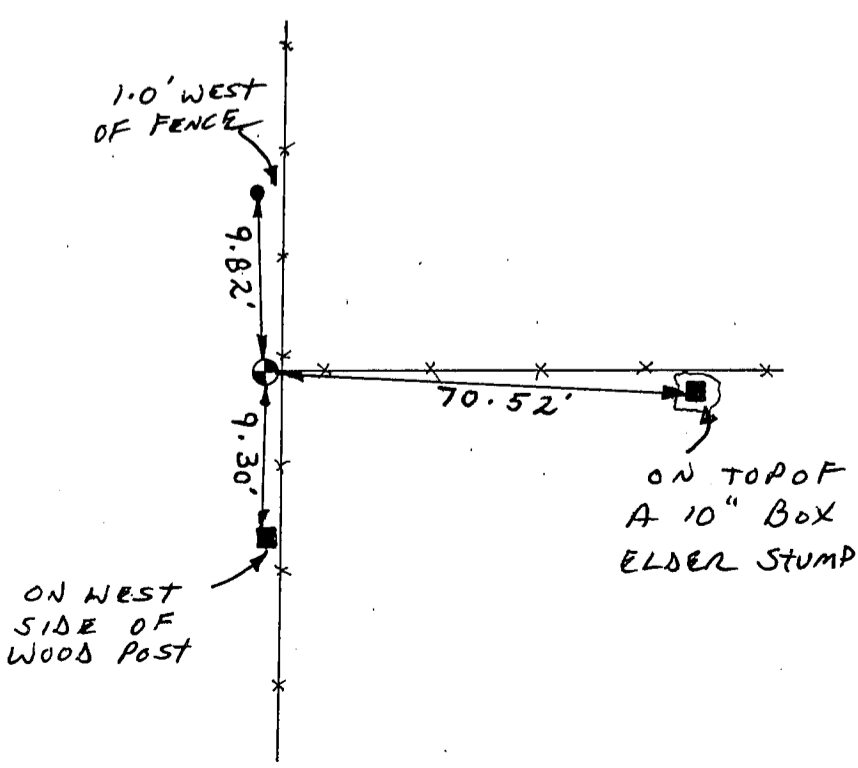

NO SCALE

LEGEND

- ⊕ = 3/4" x 24" Iron Rod
- = P.K. NAIL w/SHINER
- = 1/2" Iron Rod
- x—x— = EXISTING FENCE