

U.S. PUBLIC LAND SURVEY MONUMENT RECORD – GRANT COUNTY, WI


Section 6, Town 3 North Range 3 West, Town of Potosi

CERTIFICATE

I, Larry L. Austin, do hereby certify that the corner location on this record was determined by me and/or under my direct supervision and that this U.S. public land survey monument record is correct and complete to the best of my knowledge and belief.

Dated this 16th day of March, 2005

Larry L. Austin
Larry L. Austin S-1903

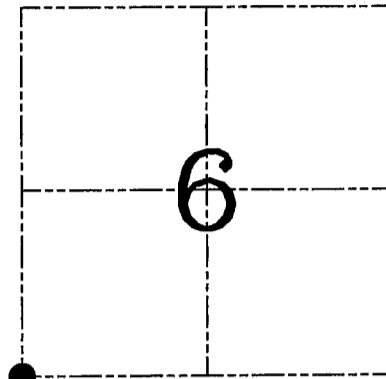

● = CORNER LOCATION

HISTORY OF CORNER ESTABLISHMENT


Corner was originally set in 1833 by Clark.
In 1880 Barber found one Bearing Tree. In 1899 Sampson measured to the corner with no mention of monument.

DESCRIPTION OF CORNER EVIDENCE FOUND

I found and accepted an occupied location which fit the Sampson survey and was proportionate in the same.
Verified this location using EDM/GPS methods.

DESCRIPTION OF CORNER AND WITNESS MONUMENTS, references and accessories used to perpetuate the original or re-established location of this corner. Witnesses to corner location Bobby Sedgwick & Brad Digman & Shane Austin

SKETCH:

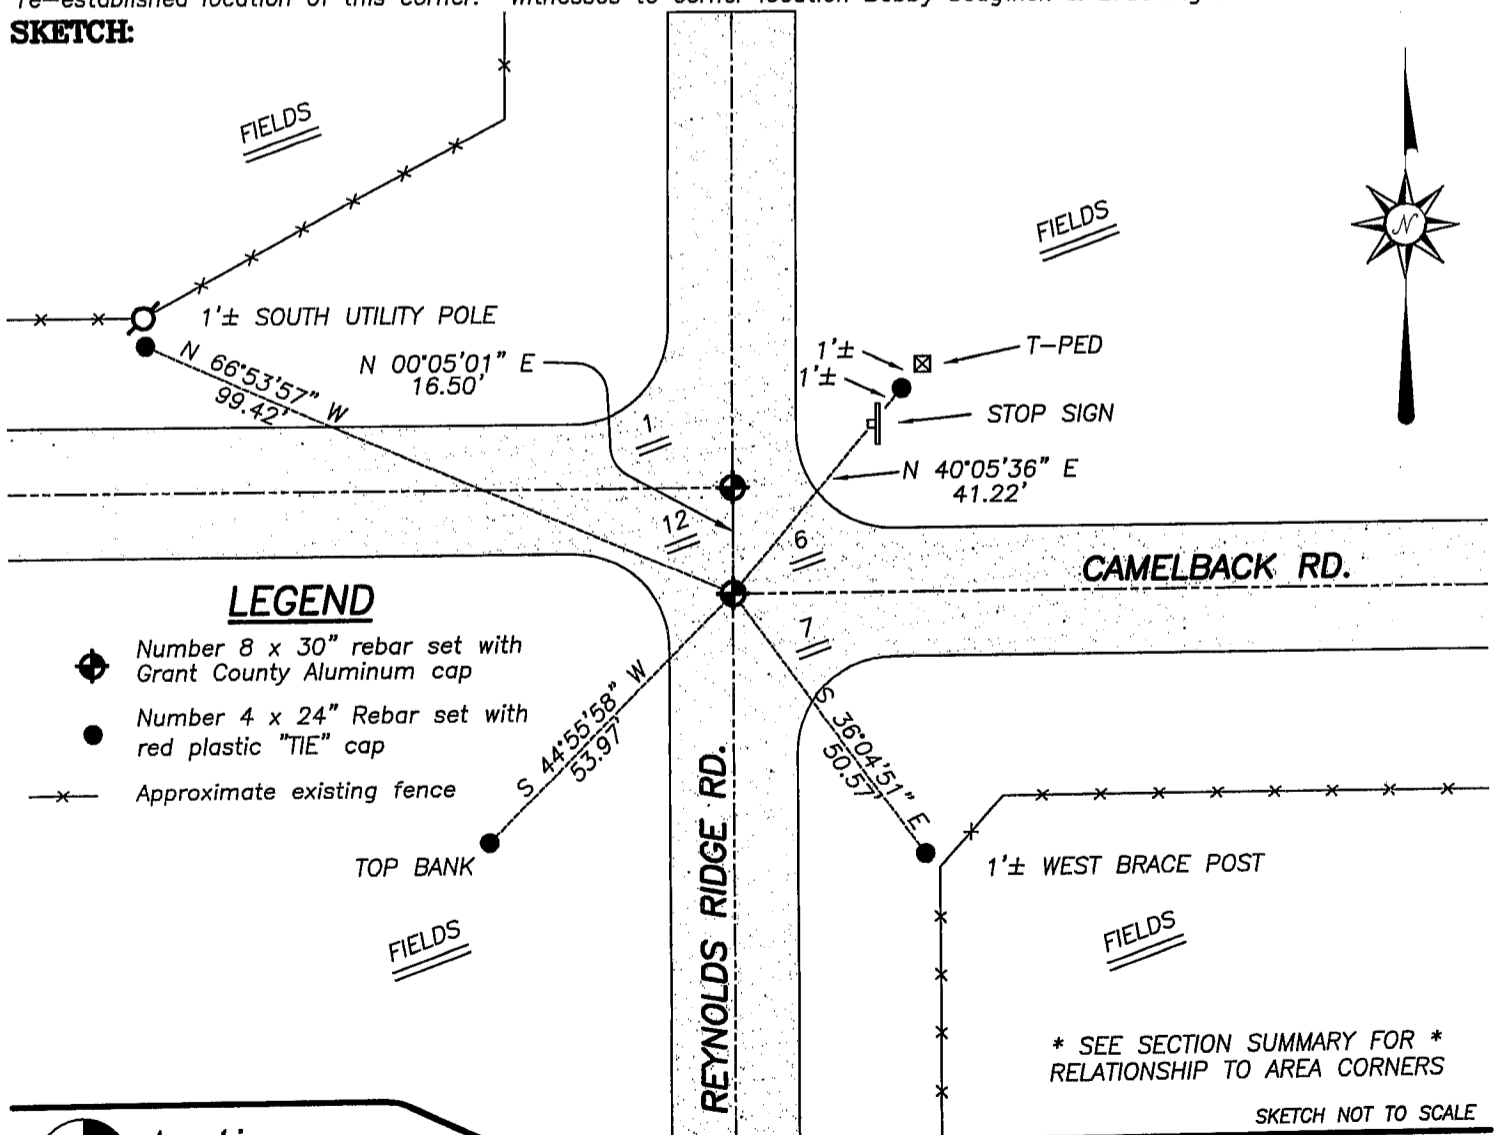

Austin Engineering LLC

4211 HWY 81 E, LANCASTER, WI 53813
PHONE 608-723-6363 FAX 608-723-6702

JOB NUMBER 05S022
FIELDBOOK: TDSR, 2517
G:\T3NR3W\T3NR3W
H:\TIE\T3NR3W\33

DRAWN BY: BJ HAZEN
APPROVED: LL AUSTIN